

LAND CORNER RECORDATION CERTIFICATE

Filing Requirement of Act 74, Mich. PA 1970

For Corners In: Presque Isle (County)	Located In	Corner Code #
1. Public Land Survey	T _____ R _____	_____
	T _____ R _____	_____
2. Property Controlling in Section	S 20 T 33N R 4E	14
	S 20 T 33N R 4E	12
3. Miscellaneous Property in Section	S _____ T _____ R _____	_____
	S _____ T _____ R _____	_____


4. Lot No: _____ Recorded Plat: _____

5. Private Claims: _____

I, Carl T. Kiiskila, in a field survey on May 6, 2002 do hereby state that under requirements of PA 74, Michigan PA of 1970, the corner points mentioned in lines 1 and 2 above were in conformance with regulations and rules therefore as required in the current manual of survey instructions of the United States Department of the Interior, Bureau of Land Management or by a decree of a Court of Law and/or that the corner points mentioned in lines 3, 4 and 5 above were in conformance with the rules of the Michigan Board of Land Surveyors or by a Decree of a Court of Law; established, re-established, monumented, recovered, found as expressed below:

NOTE: Not more than 2 corners, all in the same town and range, may be recorded on this certificate.

Register of Deeds Stamp & File Number

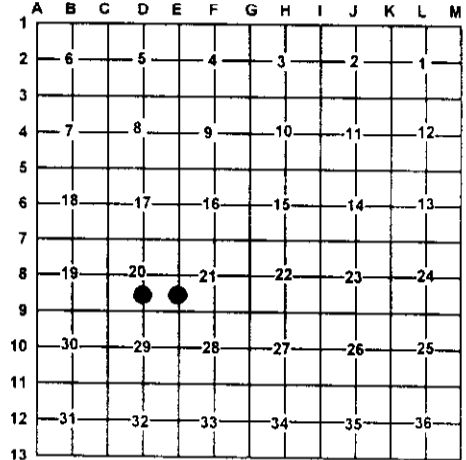

A. Description of original monument and accessories and/or subsequent restoration:

14- Delmer E. Porter June 1991 certificate of survey shows he set a 1/2" capped rod for the corner. No witnesses given. 12- This corner position was not established during the original government survey.

B. Description of corner evidence found and/or method applies in restoring or re-establishing corner:

14- Found 1/2" rod w/ P.S. cap #15410. 12- Established the Southwest corner of the Northwest quarter of the Southeast quarter of section 20, per B.L.M. instruction for subdivision of a section.

C. Description of monument for corner and accessories established to perpetuate locating the position of the corner:

14- Found 1/2" rod w/ P.S. cap #15410 Wit: 3" White Pine N13°W 31.26' 14" Oak S77°W 72.55' 3" Papal S05°E 26.17' 8" Maple N36°W 49.40' Carsonite Post North 1±	12- Set 5/8" X 32" rered with P.S. cap #33981 Wit: 12" Twin Oak N28°W 5.76' 6" Oak S24°E 23.24' 8" Oak S30°W 14.71' 6" Oak N67°E 45.04'
---	---

Signed by:

Carl T. Kiiskila

Date:

8-26-02

Surveyor's Michigan License No.:

33981

