

# LAND CORNER RECORDATION CERTIFICATE

Filing Requirement of Act 74, Mich. PA 1970

For Corners In: Presque Isle (County)	Located In	Corner Code #
1. Public Land Survey	T 33N R 4E	C-11
	T 33N R 4E	D-13
2. Property Controlling in Section	S T R	_____
	S T R	_____
3. Miscellaneous Property in Section	S T R	_____
	S T R	_____


4. Lot No: \_\_\_\_\_ Recorded Plat: \_\_\_\_\_

5. Private Claims: \_\_\_\_\_

I, Carl T. Kiiskila, in a field survey on January 30, 2002 do hereby state that under requirements of PA 74, Michigan PA of 1970, the corner points mentioned in lines 1 and 2 above were in conformance with regulations and rules therefore as required in the current manual of survey instructions of the United States Department of the Interior, Bureau of Land Management or by a decree of a Court of Law and/or that the corner points mentioned in lines 3, 4 and 5 above were in conformance with the rules of the Michigan Board of Land Surveyors or by a Decree of a Court of Law; established, re-established, monumented, recovered, found as expressed below:

**NOTE: Not more than 2 corners, all in the same town and range, may be recorded on this certificate.**

Register of Deeds Stamp & File Number

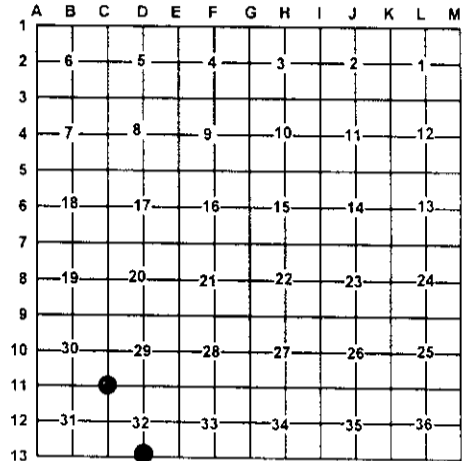

**A. Description of original monument and accessories and/or subsequent restoration:**

C-11 G.L.O. Alfred Miller D.S. 1855.  
Set post corner of section 29, 30, 31, and 32  
Wit: Spruce Pine 12 N28°W 24 links  
Black Oak 8 S08°E 13 links

D-13 G.L.O. John Hodgson D.S. 1840  
Set quarter section post  
Wit: Pine 12 N35°W 27 links  
Pine 12 N82°E 18 links

L.C.R.C. L.1 Page 717 June 1988 Ronald R. Bischer L.S. #22428 set 1/2" rod by single proportion.  
Wit: S29°E 8.59' 14" Oak, S80°W 20.40 16" Oak,  
N52°E 36.00 8" Maple

L.C.R.C. L.1 P. 717 June 1988 Ronald R. Bischer L.S. #22428. Set 1/2" rod by single proportion.  
Wit: S72°E 19.89' 4" Maple, S80°E 15.37' 1/2" rod,  
N54°E 29.99' 12" Oak.

**B. Description of corner evidence found and/or method applies in restoring or re-establishing corner:**

C-11 Found 1/2" rod with cap L.S. #22428 Bischer

D-13 Found 1/2" rod with cap L.S. #22428 Bischer

**C. Description of monument for corner and accessories established to perpetuate locating the position of the corner:**

C-11 Found 1/2" rod with cap L.S. #22428 Bischer  
Set D.N.R. monument  
Wit: 6" Red Pine S64°W 59.96'  
3" White Pine N70°W 42.25'  
Fence Corner Post N70°E 18.49'  
20" Oak S62°E 24.99'  
Carsonite Post North 1±

D-13 Found 1/2" rod with cap L.S. #22428 Bischer  
Set D.N.R. monument  
Wit: 4" Maple S70°E 19.85'  
8" Maple S03°W 11.88'  
12" Oak West 39.50'  
12" Oak N26°W 62.03'  
1/2" Capped rod  
P.S. #15410 S77°E 15.36'  
Carsonite Post North 1±

Signed by:

Carl T. Kiiskila

Date:

8-26-02

Surveyor's Michigan License No.:

33981

