

# LAND CORNER RECORDATION CERTIFICATE

Filing Requirement of Act 74, Mich. PA 1970

For Corners In: Presque Isle (County)	Located In	Corner Code #
1. Public Land Survey	T _____ R _____	_____
	T _____ R _____	_____
2. Property Controlling in Section	S 32 T 33N R 4E	15
	S 32 T 33N R 4E	8
3. Miscellaneous Property in Section	S _____ T _____ R _____	_____
	S _____ T _____ R _____	_____


Register of Deeds Stamp & File Number

4. Lot No: \_\_\_\_\_ Recorded Plat: \_\_\_\_\_

5. Private Claims: \_\_\_\_\_

I, Carl T. Kiiskila, in a field survey on January 30, 2002 do hereby state that under requirements of PA 74, Michigan PA of 1970, the corner points mentioned in lines 1 and 2 above were in conformance with regulations and rules therefore as required in the current manual of survey instructions of the United States Department of the Interior, Bureau of Land Management or by a decree of a Court of Law and/or that the corner points mentioned in lines 3, 4 and 5 above were in conformance with the rules of the Michigan Board of Land Surveyors or by a Decree of a Court of Law; established, re-established, monumented, recovered, found as expressed below:

**NOTE: Not more than 2 corners, all in the same town and range, may be recorded on this certificate.**

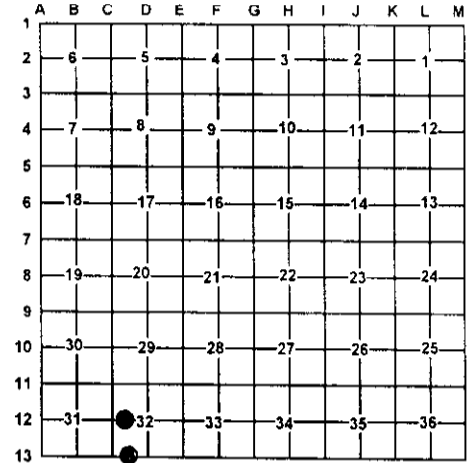

**A. Description of original monument and accessories and/or subsequent restoration:**

15- This corner position was not established during the original government survey.

8- This corner position was not established during the original government survey.

**B. Description of corner evidence found and/or method applies in restoring or re-establishing corner:**

15- Established the Southwest corner of the Southeast quarter of the Southwest quarter of section 32 as per B.L.M. instructions for the subdivision of a section.

8- Established the Northeast corner of the Northwest quarter of the Southwest quarter of section 32 as per B.L.M. instructions for the subdivision of a section.

**C. Description of monument for corner and accessories established to perpetuate locating the position of the corner:**

15- Set 5/8" X 32" rerod with P.S. cap #33981

- Wit: 8" Oak S68°W 21.09'
- 6" Oak N08°W 14.87'
- 8" Oak N43°E 12.77'
- 8" Oak S25°E 44.52'
- Carsonite Post North 1'±

8- Set 5/8" X 32" rerod with P.S. cap #33981

- Wit: 24" Red Pine S51°W 45.51'
- 6" White Pine S36°E 40.26'
- 9" White Pine N43°E 64.73'
- 12" Spruce W29°W 17.72'
- Blue Carsonite Post North 1'±

Signed by:

*Carl T. Kiiskila*

Date:

8-26-02

Surveyor's Michigan License No.:

33981

