

LAND CORNER RECORDATION CERTIFICATE


Filing Requirement of Act 74, Mich. PA 1970

For Corners In: Presque Isle (County)	Located In	Corner Code #
1. Public Land Survey	T <u>33N</u> R <u>4E</u>	<u>E-11</u>
	T <u>33N</u> R <u>4E</u>	<u>D-11</u>
2. Property Controlling in Section	S _____ T _____ R _____	_____
	S _____ T _____ R _____	_____
3. Miscellaneous Property in Section	S _____ T _____ R _____	_____
	S _____ T _____ R _____	_____
4. Lot No: _____	Recorded Plat: _____	
5. Private Claims: _____		

Register of Deeds Stamp & File Number

I, Carl T. Kiiskila, in a field survey on January 29, 2002 do hereby state that under requirements of PA 74, Michigan PA of 1970, the corner points mentioned in lines 1 and 2 above were in conformance with regulations and rules therefore as required in the current manual of survey instructions of the United States Department of the Interior, Bureau of Land Management or by a decree of a Court of Law and/or that the corner points mentioned in lines 3, 4 and 5 above were in conformance with the rules of the Michigan Board of Land Surveyors or by a Decree of a Court of Law; established, re-established, monumented, recovered, found as expressed below:

NOTE: Not more than 2 corners, all in the same town and range, may be recorded on this certificate.

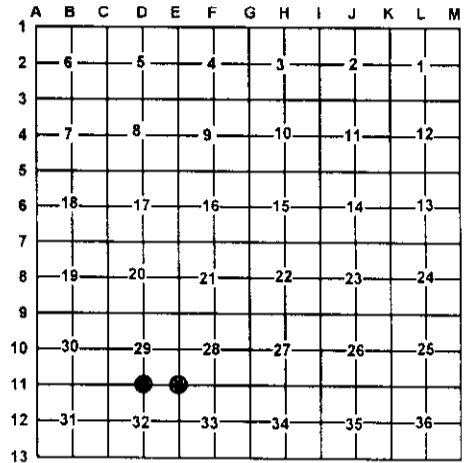

A. Description of original monument and accessories and/or subsequent restoration:

E-11 G.L.O. Alfred Millerd D.S. 1855
Set post corner section 28, 29, 32, and 33
Wit: White Pine 12 N30°E 15 links
Yellow Pine 11 S58°W 28 links

D-11 G.L.O. Alfred Millerd D.S. 1855
Set quarter section post
Wit: Yellow Pine 10 N05°E 38 links
Yellow Pine 12 S25°W 15 links

Page 687, Presque Isle County Land Corner Records,
June 1986 Carl R. Johnson P.S. #30083 set corner by single
proportionate measurement between the NW corner of
section 28 and the SW corner of section 33 one possible
U.S.B.T. stump fits this position. Set DNR monument.
Wit: 16" Red Pine N55°W 154.5', 5" Red Pine S78°E 66.4'

B. Description of corner evidence found and/or method applies in restoring or re-establishing corner:

E-11 Found D.N.R. monument and cedar post.

D-11 Re-established the North quarter corner of section 32
midway and on line between C-11 and E-11.

C. Description of monument for corner and accessories established to perpetuate locating the position of the corner:

E-11 Found D.N.R. monument and cedar post.
Wit: *12" Red Pine S72°E 66.52'
8" Red Pine S34°E 69.81'
*24" Oak N47°W 155.73'
12" Red Pine N75°E 88.14'
Carsonite Post North 1'±

D-11 Set D.N.R. Monument
Wit: 16" Oak S76°E 30.59'
16" Oak N27°E 44.41'
6" Jack Pine N44°W 54.21'
6" Jack Pine S80°W 41.74'
Carsonite Post North 1'±

* Old witnesses by others

Signed by: Carl T. Kiiskila
Surveyor's Michigan License No.: 33981

Date: 8-26-02

