

LAND CORNER RECORDATION CERTIFICATE


Filing Requirement of Act 74, Mich. PA 1970

For Corners In: <u>Presque Isle</u> (County)	Located In	Corner Code #	
1. Public Land Survey	T _____ R _____		
	T _____ R _____		
2. Property Controlling in Section	S <u>26</u> T <u>33 N</u> R <u>8 E</u>		<u>12</u>
	S <u>35</u> T <u>33 N</u> R <u>8 E</u>		<u>8</u>
3. Miscellaneous Property in Section	S _____ T _____ R _____		
	S _____ T _____ R _____		
4. Lot No: _____	Recorded Plat: _____		
5. Private Claims: _____			

Register of Deeds Stamp & File Number

I, Carl I. Kuskila, in a field survey on May 22, 2000 do hereby state that under requirements of PA 74, Michigan PA of 1970, the corner points mentioned in lines 1 and 2 above were in conformance with regulations and rules therefore as required in the current manual of survey instructions of the United States Department of the Interior, Bureau of Land Management or by a decree of a Court of Law and/or that the corner points mentioned in lines 3, 4 and 5 above were in conformance with the rules of the Michigan Board of Land Surveyors or by a Decree of a Court of Law; established, re-established, monumented, recovered, found as expressed below:

NOTE: Not more than 2 corners, all in the same town and range, may be recorded on this certificate.

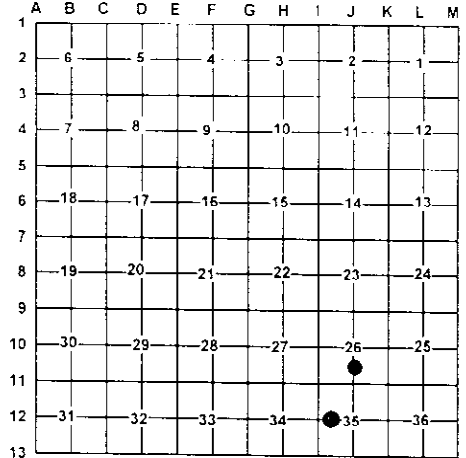

A. Description of original monument and accessories and/or subsequent restoration:

12- This corner was not established during the original government survey.

8- Liber 231 Page 311 Duane R. MacNeil, Set 3/4" pipe with P.S. cap for corner.

B. Description of corner evidence found and/or method applies in restoring or re-establishing corner:

12- Established the Northwest corner of the Southwest quarter of the Southeast quarter of section 26 per standard B.L.M. instructions for the subdivision of a section.

8- Found a 3/4" pipe with P.S. cap #19327 fitting D.R. MacNeil's survey in section 35.

C. Description of monument for corner and accessories established to perpetuate locating the position of the corner:

12- Set 5/8" x 32" rerod w/ PS cap #33981
 Wit: 10" Cedar N74°E 19.06'
 5" Balsam West 7.39'
 6" Maple S17°E 2.58'
 6" Balsam N12°W 9.19'
 3/4" pipe S19°W 26.84'
 Carsonite post North 1' ±

8- 3/4" pipe with P.S. cap #19327
 Wit: 3" Ironwood S35°W 8.53'
 3" Maple N72°W 11.22'
 8" Ironwood N24°W 14.18'
 10" Basswood S68°E 20.46'
 Carsonite post North 1' ±

Signed by:

Carl I. Kuskila

Date:

10-21-03

Surveyor's Michigan License No.:

33981

