


T34N R4E BISMARCK TWP.
 PRESQUE ISLE COUNTY 1999 STATE RECONUMENTATION

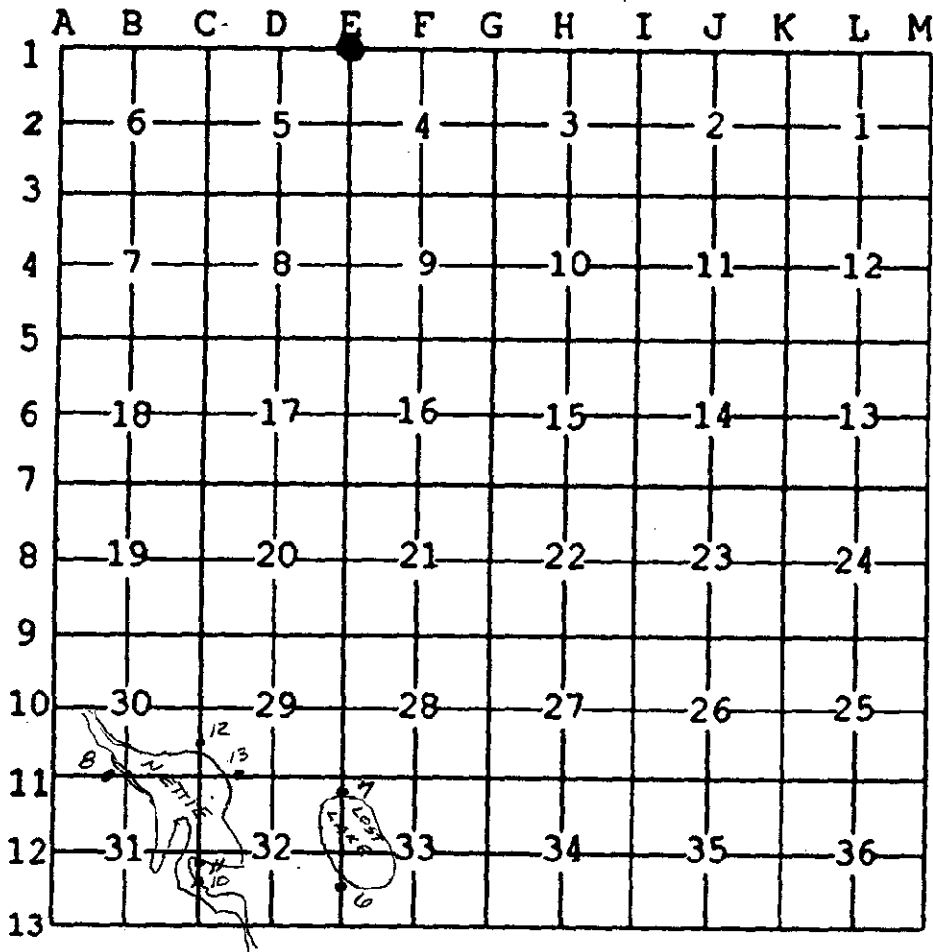

MEANDER POST
 SLIDE

7 MEANDER POSTS.

CURRY &
 R.F.

DEC 29 1999

SECTION