

LAND CORNER RECORDATION CERTIFICATE
Filing Requirement of Act 74, Mich. P.A. 1970

For corners in
PRESQUE ISLE
 (County)

	Located In:	Corner Code #
1. Public Land Survey	T <u>34N</u> R <u>4E</u>	<u>I-5, I-6</u>
	T _____ R _____	_____
	T _____ R _____	_____
	T _____ R _____	_____
2. Property Controlling in Section	S _____ T _____ R _____	_____
	S _____ T _____ R _____	_____
3. Miscellaneous Property in Sec.	S _____ T _____ R _____	_____
	S _____ T _____ R _____	_____

Register of Deeds Stamp & File Number

4. Lot No. _____, Recorded Plat _____
 5. Private Claims _____

	A	B	C	D	E	F	G	H	I	J	K	L	M
2	6	5	4	3	2	1							
3													
4	7	8	9	10	11	12							
5													
6	18	17	16	15	14	13							
7													
8	19	20	21	22	23	24							
9													
10	30	29	28	27	26	25							
11													
12	31	32	33	34	35	36							
13													

I, CARL T. KIISKILA, in a field survey on JANUARY 13, 19 97, do hereby certify that under requirements of P.A. 74, Michigan P.A. of 1970, the corner points mentioned in lines 1 and 2 above were in conformance with regulations and rules therefore as required in the current manual of survey instructions of the United States Department of the Interior, Bureau of Land Management or by a decree of a Court of Law and/or that the corner points mentioned in lines 3, 4 and 5 above were in conformance with the rules of the Michigan Board of Land Surveyors or by a Decree of a Court of Law; established, re-established, monumented, re-monumented, recovered, found as expressed below:

NOTE: Not more than 4 corners, all in the same town and range, may be recorded on this certificate.

A. Description of original monument and accessories and/or subsequent restoration:
 I-5 I-6

(NO EVIDENCE OF G.L.O. CORNER, B.T.'S, LINE TREES & TOPOGRAPHY, AS CALLED OUT IN THE G.L.O. LINE NOTES; UNLESS NOTED IN ITEM "B" BELOW.)

B. Description of corner evidence found and/or method applied in restoring or reestablishing corner:

I-5
 FOUND AND ACCEPTED A 1/2" REBAR AS WITNESSED BY DELMAR PORTER, RLS, FOUND ON PAGE 563 OF PRESQUE ISLE CO. L.C.R.C.'S. CORNER SET BY DELEMATER IN 1944. THE CORNER FITS G.L.O. SWAMP TIES NORTH, EAST AND SOUTH WELL. EAST-WEST TRAIL ROAD IS 90° SOUTH.

I-6
 FOUND AND ACCEPTED A 1 1/2" PIPE AS WITNESSED BY DELMAR PORTER, RLS, FOUND ON PAGE 563 OF PRESQUE ISLE CO. L.C.R.C.'S. THE CORNER FITS G.L.O. SWAMP TIES SOUTH WELL.


C. Description of monument for corner and accessories established to perpetuate locating the position of the corner:

I-5
 FOUND 1/2" ROD - PORTER, ADDED 1 1/4"x 32" IRON PIPE W/CAP & SET CARSONITE POST.
 † 6" TW. MAPLE N78°E 69.48'
 4" W.PINE N77°W 51.69'
 †10" W.BIRCH S51°W 55.85'
 2" MAPLE N17°E 62.44'
 FENCE CORNER(SMOOTH WIRE N & E) N05 W 32.3'

I-6
 FOUND 1 1/2" PIPE WITH 1/2" REBAR & D.PORTER RLS CAP
 †7" MAPLE N34°W 30.17'
 †6" MAPLE S81°W 41.14'
 †6" MAPLE S53°E 44.59'
 SW CABIN CORNER N64°E 87.48'

† OLD WIT BY D.PORTER.

† OLD WITNESSES BY PORTER.

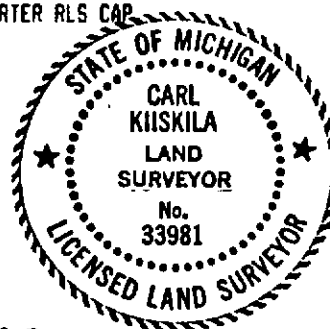

Signed by Carl T. Kiiskila Date 2-27-97

Surveyor's Michigan License No. 33981