

8605

1999 PRESQUE ISLE COUNTY, STATE OF MICHIGAN REMONUMENTATION RECORDED PRESQUE ISLE COUNTY

LAND CORNER RECORDATION CERTIFICATE Filing Requirement of Act 74, Mich. P.A. 1970

1999 DEC -2 PM 2:03

For corners in

Presque Isle (County)

Located In:

Corner Code #

1. Public Land Survey

T34 R4E A-1

T R

T R

T R

2. Property Controlling in Section

S T R

S T R

3. Miscellaneous Property in Sec.

S T R

S T R

Jane M. Lamb REGISTER OF DEEDS

SURVEY A

DEC 29 1999

SECTION

Register of Deeds Stamp & File Number

4. Lot No. , Recorded Plat

5. Private Claims

I, Delmer E. Porter in a field survey on Nov. 10, 1999 do hereby state that under requirements of P.A. 74, Michigan P.A. of 1970, the corner points mentioned in lines 1 and 2 above were in conformance with regulations and rules therefore as required in the current manual of survey instructions of the United States Department of the Interior, Bureau of Land Management or by a decree of a Court of Law and/or that the corner points mentioned in lines 3, 4 and 5 above were in conformance with the rules of the Michigan Board of Land Surveyors or by a Decree of a Court of Law; established, re-established, monumented, recovered, found as expressed below.

NOTE: Not more than 2 corners, all in the same town and range, may be recorded on this certificate.


Grid table with columns A-M and rows 1-13. Contains numbers 6-36.

A. Description of original monument and accessories and/or subsequent restoration:

A-1 GLO Notes

Post 18" Pine S81°E 24 Lks 12" Pine N71°W 42 Lks

K. Ostling, Sept. 4, 1980 Liber 1, Page 543 Fd. P.I. County Mon. in place N54°W 42.9' 7" R. Pine N33°E 38.8' 12" Twin Oak NE 30' Cedar Post

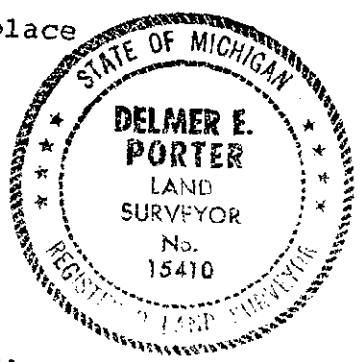

B. Description of corner evidence found and/or method applied in restoring or reestablishing corner:

A-1 Fd. 4" Conc Mon in place

S55°W 42.9' to Face Blaze 12" R. Pine N33°E 38.8' to Face Blaze 29" Tw. Oak N54°E 59.95' 9" J. Pine (OW) Dead (Lib.1, Page 353)(Lib. 1, Page 324) N36°W 49.01' US BM Conc Mon NE 30' Cedar Post

C. Description of monument for corner and accessories established to perpetuate locating the position of the corner:

A-1 4" Conc Mon/Brass Cap

S53°W 53.31' 9" Oak N55°W 43.17' 12" Red Pine (42.90' to Face) N04°W 38.00' 8" Red Pine N33°E 39.73' 29" Twin Oak N45°E 30.29' Cedar Post S28°E 60.91' 14" Oak

Ratified by Peer Group in accordance with P.A. 345

Chairman [Signature]

Date 11/30/99

*Witness tags & nails used.

Signed by [Signature]

Surveyor's Michigan License No. #15410

Date 11-15-99