

5610

1999 PRESQUE ISLE COUNTY, STATE OF MICHIGAN REMONUMENTATION

1999 DEC -2 PM 2: 11

LAND CORNER RECORDATION CERTIFICATE
Filing Requirement of Act 74, Mich. P.A. 1970

For corners in

Presque Isle
(County)

Located In:

Corner Code #

1. Public Land Survey

T 34 R 4E A-6

T _____ R _____

T _____ R _____

T _____ R _____

2. Property Controlling in Section

S _____ T _____ R _____

S _____ T _____ R _____

3. Miscellaneous Property in Sec.

S _____ T _____ R _____

S _____ T _____ R _____

Jane M. Lamb
REGISTER OF DEEDS

DEC 29 1999

SECTION

Register of Deeds Stamp & File Number

4. Lot No. _____, Recorded Plat _____

5. Private Claims _____

I, Delmer E. Porter in a field survey on Nov. 10, 1999 do hereby state that under requirements of P.A. 74, Michigan P.A. of 1970, the corner points mentioned in lines 1 and 2 above were in conformance with regulations and rules therefore as required in the current manual of survey instructions of the United States Department of the Interior, Bureau of Land Management or by a decree of a Court of Law and /or that the corner points mentioned in lines 3, 4 and 5 above were in conformance with the rules of the Michigan Board of Land Surveyors or by a Decree of a Court of Law; established, re-established, monumented, recovered, found as expressed below:

NOTE: Not more than 2 corners, all in the same town and range, may be recorded on this certificate.

	A	B	C	D	E	F	G	H	I	J	K	L	M
1													
2	6		5		4		3		2		1		
3													
4	7		8		9		10		11		12		
5													
6	18		17		16		15		14		13		
7													
8	19		20		21		22		23		24		
9													
10	30		29		28		27		26		25		
11													
12	31		32		33		34		35		36		
13													


A. Description of original monument and accessories and/or subsequent restoration:

A-6 GLO Notes - 1855
Set 1/4 Section Post
Y Birch 22" N59°W 66 Lks
Hemlock 10" S72°W 36½ Lks

R. Bischer #22428
L 1, Pg 545 & L 1, Pg 547
2" Pipe
3 Witnesses by Louis Zubak
9" Pine N33°W 28.16'
11" Pine N70°E 10.30'
16" Pine S30°W 42.21'
Used nails set by Louis C. Zubak

B. Description of corner evidence found and/or method applied in restoring or reestablishing corner:

A-6 Found 2" Pipe in Place
N35°W 28.60' 14" N. Pine (no nails fd in trees)
N72°E 10.85' 18" W. Pine (no nails fd in trees)

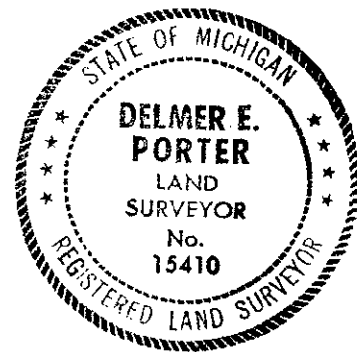

C. Description of monument for corner and accessories established to perpetuate locating the position of the corner:

A-6 2" Pipe
S05°E 70.50' W. Pine
N61°W 28.34' 15" Norway
N35°W 28.60' 14" Norway
N72°E 10.85' 18" W. Pine
Note: All new tags & nails were used.

Flatified by Peer Group
in accordance with P.A. 345
Chairman *Norman J. Quinn*
Date 11/30/99

*Witness tags & nails used.

Signed by *Delmer E. Porter*
Surveyor's Michigan License No. #15410

Date 11-15-99