

LAND CORNER RECORDATION CERTIFICATE  
Filing Requirement of Act 74, Mich. P.A. 1970

DEC 29 1999

For corners in

<u>Presque Isle</u> (County)	Located In:	Corner Code #
1. Public Land Survey	T <u>34</u> R <u>4E</u>	<u>A-10</u> ✓
	T ___ R ___	_____
	T ___ R ___	_____
	T ___ R ___	_____
2. Property Controlling in Section	S ___ T ___ R ___	_____
	S ___ T ___ R ___	_____
3. Miscellaneous Property in Sec.	S ___ T ___ R ___	_____
	S ___ T ___ R ___	_____

SECTION

PRESQUE ISLE COUNTY  
RECORDED

1999 DEC -2 PM 2: 12

*Janet M. Lamb*

REGISTER OF DEEDS  
Register of Deeds Stamp & File Number

4. Lot No. \_\_\_\_\_, Recorded Plat \_\_\_\_\_  
5. Private Claims \_\_\_\_\_

I, Delmer E. Porter in a field survey on Nov. 11, 1999 do hereby state that under requirements of P.A. 74, Michigan P.A. of 1970, the corner points mentioned in lines 1 and 2 above were in conformance with regulations and rules therefore as required in the current manual of survey instructions of the United States Department of the Interior, Bureau of Land Management or by a decree of a Court of Law and /or that the corner points mentioned in lines 3, 4 and 5 above were in conformance with the rules of the Michigan Board of Land Surveyors or by a Decree of a Court of Law, established, re-established, monumented, recovered, found as expressed below:

NOTE: Not more than 2 corners, all in the same town and range, may be recorded on this certificate.


	A	B	C	D	E	F	G	H	I	J	K	L	M
1													
2	6		5		4		3		2		1		
3													
4	7		8		9		10		11		12		
5													
6	18		17		16		15		14		13		
7													
8	19		20		21		22		23		24		
9													
10	30		29		28		27		26		25		
11													
12	31		32		33		34		35		36		
13													

A. Description of original monument and accessories and/or subsequent restoration:

A-10 GLO Notes - 1855	R. Bischer #22428, L 1 Pg 216
Set 1/4 Sec Post	Set 1/2" Rod & Cap by S.P.
12" Spruce N55° E 5 Lks	N08° E 12.48' 6" Birch
8" Spruce S20° E 6 Lks	S75° E 19.25' 6" Birch
	S26° W 9.64' 7" Spruce

B. Description of corner evidence found and/or method applied in restoring or reestablishing corner:

A-10 Found 1/2" Rod & Cap  
 N08° E 12.48' 6" Birch  
 S75° E 19.25' 6" Birch  
 S26° W 9.64' 7" Spruce

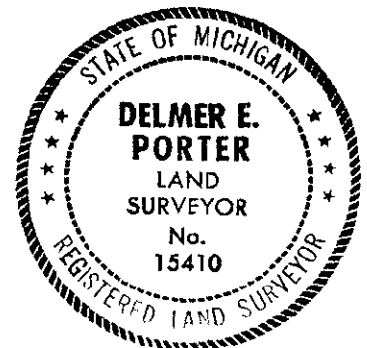

C. Description of monument for corner and accessories established to perpetuate locating the position of the corner:

A-10 1/2" Rod & Cap  
 S26° W 9.64' 8" Birch  
 N40° W 5.66' 4" Spruce  
 N08° E 12.48' 7" Birch  
 S75° E 19.25' 7" Birch

\*Witness tags & nails used.

Ratified by Peer Group  
in accordance with P.A. 345

Chairman *William J. O'Leary*  
Date 11/30/99

Signed by *Delmer E. Porter*  
Surveyor's Michigan License No. #15410

Date 11-15-99