

DEC 29 1999

1999 PRESQUE ISLE COUNTY, STATE OF MICHIGAN REMONUMENTATION

LAND CORNER RECORDATION CERTIFICATE
Filing Requirement of Act 74, Mich. P.A. 1970

SECTION

For corners in

Table with columns: Presque Isle (County), Located In:, Corner Code #. Row 1: Public Land Survey, T34 R4E, A-11. Row 2: Property Controlling in Section, S, T, R. Row 3: Miscellaneous Property in Sec., S, T, R.

PRESQUE ISLE COUNTY RECORDED

1999 DEC -2 PM 2: 12

Signature of Janet M. Lamb, REGISTER OF DEEDS

Register of Deeds Stamp & File Number

4. Lot No. , Recorded Plat
5. Private Claims

Grid table with columns A-M and rows 1-13. Contains numbers 1-36 in a grid pattern.

I, Delmer E. Porter in a field survey on Nov. 11, 1999 do hereby state that under requirements of P.A. 74, Michigan P.A. of 1970, the corner points mentioned in lines 1 and 2 above were in conformance with regulations and rules therefore as required in the current manual of survey instructions of the United States Department of the Interior, Bureau of Land Management or by a decree of a Court of Law and /or that the corner points mentioned in lines 3, 4 and 5 above were in conformance with the rules of the Michigan Board of Land Surveyors or by a Decree of a Court of Law; established, re-established, monumented, recovered, found as expressed below:

NOTE: Not more than 2 corners, all in the same town and range, may be recorded on this certificate.


A. Description of original monument and accessories and/or subsequent restoration:

A-11 GLO Notes - 1855
Set Post/Cor Sec 25&26
T33N, R3E
10" Pine S26°E 11 Lks
19" Pine N68°W 45 Lks

R. Bischer #22428, L 1, Pg 216
Fd 1" Pipe & 3 Witnesses
And both "O.B.T." Stumps
N45°W 14.72' 5" Maple
S10°W 11.29' 6" Aspen
N70°E 14.70' 6" Aspen

B. Description of corner evidence found and/or method applied in restoring or reestablishing corner:

A-11 Found 1" Pipe with T Bar (S80°W 0.30')
Found 2 of Bischer's witnesses
N45°W 14.50' 6" Maple (New Nail)
S19°W 11.32' 11" Aspen (New Nail)
No nails & tags were found

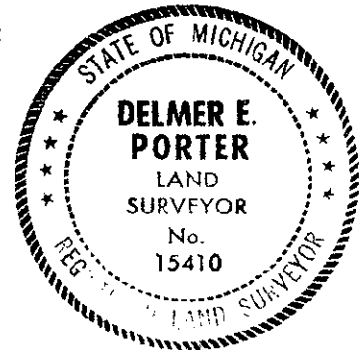

C. Description of monument for corner and accessories established to perpetuate locating the position of the corner:

A-11 1" Pipe with T-Bar
S19°W 11.32' 11" Poplar
S28°W 8.00' Old Stump
N70°W 2.20' 7" Maple
N45°W 14.50' 6" Maple
S35°E 12.74' 7" Poplar

Ratified by Peer Group in accordance with P.A. 345
Chairman Norman J. Okami
Date 11/30/99

*Witness tags & nails used.

Signed by Delmer E. Porter
Surveyor's Michigan License No. #15410

Date 11-15-99