

LAND CORNER RECORDATION CERTIFICATE
Filing Requirement of Act 74, Mich. P.A. 1970

SECTION

For corners in

<u>Presque Isle</u> (County)	Located in:	Corner Code #
1. Public Land Survey	T 34 R 4E	A-13 ✓
	T ___ R ___	_____
	T ___ R ___	_____
	T ___ R ___	_____
2. Property Controlling in Section	S ___ T ___ R ___	_____
	S ___ T ___ R ___	_____
3. Miscellaneous Property in Sec.	S ___ T ___ R ___	_____
	S ___ T ___ R ___	_____
4. Lot No. _____, Recorded Plat _____		
5. Private Claims _____		

PRESQUE ISLE COUNTY
RECORDED
1999 DEC -2 PM 2:12
Janet M. Lamb
REGISTER OF DEEDS
Register of Deeds Stamp & File Number


A	B	C	D	E	F	G	H	I	J	K	L	M
1												
2	6	5	4	3	2	1						
3												
4	7	8	9	10	11	12						
5												
6	18	17	16	15	14	13						
7												
8	19	20	21	22	23	24						
9												
10	30	29	28	27	26	25						
11												
12	31	32	33	34	35	36						
13												

I, Delmer E. Porter in a field survey on Nov. 11, 1999 do hereby state that under requirements of P.A. 74, Michigan P.A. of 1970, the corner points mentioned in lines 1 and 2 above were in conformance with regulations and rules therefore as required in the current manual of survey instructions of the United States Department of the Interior, Bureau of Land Management or by a decree of a Court of Law and /or that the corner points mentioned in lines 3, 4 and 5 above were in conformance with the rules of the Michigan Board of Land Surveyors or by a Decree of a Court of Law; established, re-established, monumented, recovered, found as expressed below:

NOTE: Not more than 2 corners, all in the same town and range, may be recorded on this certificate.

A. Description of original monument and accessories and/or subsequent restoration:
 A-13 GLO Notes - 1855 R. Bischer #22428
 Set Post Corner 3/4" Pipe
 Twp. 33& 34, R3&4E N79°W 84.29' 20" Oak
 24" Pine N60°W 18 Lks N42°E 45.89' 10" Oak
 6" B1 Oak S48°W 18 Lks

B. Description of corner evidence found and/or method applied in restoring or reestablishing corner:
 A-13 Found 3/4" Pipe and both of Bischer's witnesses
 N79°W 84.29' 27" Oak
 N42°E 45.89' 20" Stump
 N31°W 11.29' Scott's 1/2" Rod
 Scott's 1/2" Rod recorded by Porter L 1, Pg 111

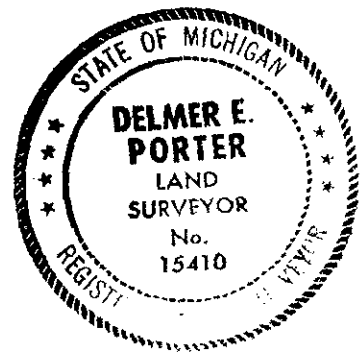

C. Description of monument for corner and accessories established to perpetuate locating the position of the corner:
 A-13 3/4" Pipe
 S73°W 51.34' 13" Oak
 S53°W 72.45' 14" Oak
 S15°W 10.55' 11" Oak
 N79°W 84.32' 27" Oak
 N31°W 11.29' Scott's 1/2" Rod
 N42°E 45.89' 20" Stump at 46'

Notified by Freer Group
 in accordance with P.A. 345
 Chairman Norman J. Quinn
 Date 11/30/99

*Witness tags & nails used.

Signed by Delmer E. Porter Date 11-15-99
 Surveyor's Michigan License No. #15410