

DEC 29 1999

LIBER 334 PAGE 935

1999 PRESQUE ISLE COUNTY, STATE OF MICHIGAN REMONUMENTATION

SECTION

LAND CORNER RECORDATION CERTIFICATE
Filing Requirement of Act 74, Mich. P.A. 1970

For corners in

<u>Presque Isle</u> (County)	Located In:	Corner Code #
1. Public Land Survey	T34 R4E	B-7 ✓
	T R	
	T R	
	T R	
2. Property Controlling in Section	S T R	
	S T R	
3. Miscellaneous Property in Sec.	S T R	
	S T R	

PRESQUE ISLE COUNTY
RECORDED

1999 DEC -2 PM 2:13

Jane M. Lamb
REGISTER OF DEEDS

Register of Deeds Stamp & File Number

4. Lot No. _____, Recorded Plat _____
5. Private Claims _____

I, Delmer E. Porter, in a field survey on Nov. 12, 1999 do hereby state that under requirements of P.A. 74, Michigan P.A. of 1970, the corner points mentioned in lines 1 and 2 above were in conformance with regulations and rules therefore as required in the current manual of survey instructions of the United States Department of the Interior, Bureau of Land Management or by a decree of a Court of Law and for that the corner points mentioned in lines 3, 4 and 5 above were in conformance with the rules of the Michigan Board of Land Surveyors or by a Decree of a Court of Law; established, re-established, monumented, recovered, found as expressed below.

A	B	C	D	E	F	G	H	I	J	K	L	M
1												
2	6	5	4	3	2	1						
3												
4	7	8	9	10	11	12						
5												
6	18	17	16	15	14	13						
7	•											
8	19	20	21	22	23	24						
9												
10	30	29	28	27	26	25						
11												
12	31	32	33	34	35	36						
13												

NOTE: Not more than 2 corners, all in the same town and range, may be recorded on this certificate.


A. Description of original monument and accessories and/or subsequent restoration:

B-7 GLO Notes - 1856
Set Quarter Section Post
18" Y Pine N5° E 48 Lks
18" Y Pine S10° W 29 Lks

R. Bischer #22428, L 1, Pg 575
Set 1/2" Rod & Cap by S.P.
N47° W 120.73 8" W. Pine
N60° E 20.27' P Pole
N81° E 35.30' 4" W. Pine

B. Description of corner evidence found and/or method applied in restoring or reestablishing corner:

B-7 Fd. 1/2" Rod/Cap #15410
N47° W 120.73' 17" W. Pine
N60° E 20.27' P. Pole
N81° E 35.30' 8" W. Pine

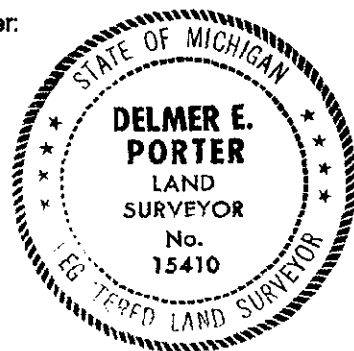

C. Description of monument for corner and accessories established to perpetuate locating the position of the corner:

B-7 1/2" Rod & Cap
S24° W 34.27' 8" Balsam
N47° W 120.73' 17" W. Pine
N60° E 20.27' Power Pole
N81° E 35.30' 8" W. Pine

*Witness tags & nails used.

Ratified by Peer Group
in accordance with P.A. 345

Chairman Norman J. Quinn
Date 11/30/99

Signed by Delmer E. Porter
Surveyor's Michigan License No. #15410

Date 11-15-99