

DEC 29 1999

1999 PRESQUE ISLE COUNTY, STATE OF MICHIGAN REMONUMENTATION

SECTION

LAND CORNER RECORDATION CERTIFICATE
Filing Requirement of Act 74, Mich. P.A. 1970

For corners in

Table with columns: Presque Isle (County), Located In:, Corner Code #. Rows include Public Land Survey, Property Controlling in Section, Miscellaneous Property in Sec., Lot No., and Private Claims.

PRESQUE ISLE COUNTY RECORDED

1999 DEC -2 PH 2: 13

Janet M. Lamb REGISTER OF DEEDS

Register of Deeds Stamp & File Number

Grid table with columns A-M and rows 1-13. Contains numerical data for recording purposes.

I, Delmer E. Porter in a field survey on Nov. 12, 1999 do hereby state that under requirements of P.A. 74, Michigan P.A. of 1970, the corner points mentioned in lines 1 and 2 above were in conformance with regulations and rules therefore as required in the current manual of survey instructions of the United States Department of the Interior, Bureau of Land Management or by a decree of a Court of Law and/or that the corner points mentioned in lines 3, 4 and 5 above were in conformance with the rules of the Michigan Board of Land Surveyors or by a Decree of a Court of Law; established, re-established, monumented, recovered, found as expressed below:


NOTE: Not more than 2 corners, all in the same town and range, may be recorded on this certificate.

A. Description of original monument and accessories and/or subsequent restoration:

B-9 GLO Notes - 1856 Set Quarter Section Post 12" W Birch S50°W 9 Lks 10" W Pine N40°E 13 Lks N. Quaine #33984, L 1, Pg 192 1/2" Rod & Cap #15410 N21°E 16.42' 16" Balsam N67°W 25.78' 10" Birch S84°E 29.82' 8" Balsam S25°W 45.92' 4" Balsam

B. Description of corner evidence found and/or method applied in restoring or reestablishing corner:

B-9 Fd. 1/2" Rod & Cap #15410 N21°E 16.42' 16" Balsam N67°W 25.78' 10" Birch S84°E 29.82' 8" Balsam S25°W 45.92' 4" Balsam

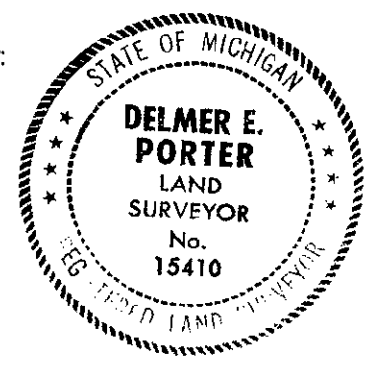

C. Description of monument for corner and accessories established to perpetuate locating the position of the corner:

B-9 1/2" Rod & Cap S25°W 45.92' 4" Balsam N67°W 25.78' 10" Birch N21°E 16.42' 16" Balsam S89°E 29.82' 8" Balsam

\*Witness tags & nails used.

Reviewed by Peer Group in accordance with P.A. 345 Chairman Norman J. Quaine Date 11/30/99

Signed by Delmer E. Porter Surveyor's Michigan License No. #15410

Date 11-15-99