

1999 PRESQUE ISLE COUNTY, STATE OF MICHIGAN,

LAND CORNER REMONUMENTATION

LIBER 335 PAGE 227

DEC 29 1999

SECTION

LAND CORNER RECORDATION CERTIFICATE
Filing Requirement of Act 74, Mich. P.A. 1970

For corners in
PRESQUE ISLE

Located In: **BISMARCK TWP.** Corner Code #: **D-11** ✓
T 34N R 4E
 T ___ R ___
 T ___ R ___
 T ___ R ___
 S ___ T ___ R ___
 S ___ T ___ R ___
 S ___ T ___ R ___
 S ___ T ___ R ___

- 1. Public Land Survey
- 2. Property Controlling in Section
- 3. Miscellaneous Property in Sec.

- 4. Lot No. _____, Recorded Plat _____
- 5. Private Claims _____

Recorded Dec 20, 1999
 At 10:30 o'clock A.M.
Janet M. Lamb
 Reg. of Deeds, Presque Isle Co. MI

Register of Deeds Stamp & File Number

I, **James A. Beck**, in a field survey on **Nov 19, 1999** do hereby state that under requirements of P.A. 74, Michigan P.A. of 1970, the corner points mentioned in lines 1 and 2 above were in conformance with regulations and rules therefore as required in the current manual of survey instructions of the United States Department of the Interior, Bureau of Land Management or by a decree of a Court of Law and for that the corner points mentioned in lines 3, 4 and 5 above were in conformance with the rules of the Michigan Board of Land Surveyors or by a Decree of a Court of Law; established, re-established, monumented, recovered, found as expressed below:

NOTE: Not more than 2 corners, all in the same town and range, may be recorded on this certificate.

A. Description of original monument and accessories and/or subsequent restoration:

D-11 1856 G.L.O. by Alfred Millerd "Set of Sec. post"; Y. Pine 14 N28W 20; W. Pine 12 S70E 24
 Circa 1940 + From Volume "Established Section Corners" on file in Presque Isle County Register of Deeds Office by G.F. DeLaMater RLS "Found both Gov't Bs & P."; R. Oak 4 N77E 30.3; R. Oak 4 S28E 29.2; R. Oak 3 S79W 14.9
 July 5, 1973; P.A. 74 Certificate by Delmer E. Porter: 1/2" rod; 4" R Oak N77E 30.30'; Pine Stump N28°W 20 links (orig w/it); 4" Red Oak S29°E 29.2'; 3" Red Oak S79°W 14.9'.
 April 20, 1977 P.A. 152 Survey by Delmer E. Porter RLS 15410; N 1/4 Corner 1/2" rod; N 80°W 15.07' 8" Oak; N78°E 31.52' 7" Oak East 10.47' 4" Conc. mon.; S30°E 29.25' 7" twin Oak


B. Description of corner evidence found and/or method applied in restoring or reestablishing corner:

D-11 November 19, 1999 Remonumentation by James A. Beck P.S. 21559; found 1/2" iron rod, found Oak stump N78°E 31.5' East 10.47' 1/2" iron rod in 4" cement cylinder - (property Corner)

in accordance with P.A. 345
 Chairman *James A. Beck*
 Date 12/14/99

C. Description of monument for corner and accessories established to perpetuate locating the position of the corner:

D-11 November 19, 1999 Remonumentation by James A. Beck P.S. 21559
 1/2" iron rod and P.S. 21559 cap
 Oak stump N78°E 31.5'; N 50°E 12.96 P.S. 21559 tag in 6" Oak
 S42°W 40.08' " " " 3" W. Pine; S10°E 25.49' " " " 3" W. Pine;
 N2°E 21.71' " " " 4" W. Pine; East 10.47' 1/2" iron rod in 4" cement cylinder
 - (property Corner); Corner falls in recent clear-cut area

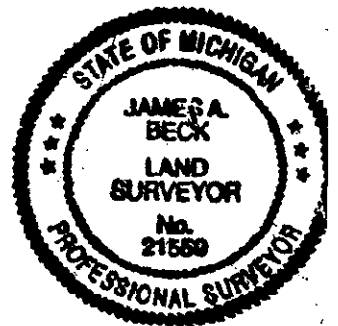

Signed by *James A. Beck*
 Surveyor's Michigan License No. 21559

Date 12-18-1999