

1999 PRESQUE ISLE COUNTY, STATE OF MICHIGAN,

LAND CORNER REMONUMENTATION

DEC 29 1999

LIBER 335 PAGE 228

SECTION

LAND CORNER RECORDATION CERTIFICATE
Filing Requirement of Act 74, Mich. P.A. 1970

For corners in
PRESQUE ISLE

(County)

Located in: **BISMARCK TWP.** Corner Code # **D-13** ✓

1. Public Land Survey **T 34N R 4E**

T ___ R ___

T ___ R ___

T ___ R ___

2. Property Controlling in Section S ___ T ___ R ___

S ___ T ___ R ___

3. Miscellaneous Property in Sec. S ___ T ___ R ___

S ___ T ___ R ___

Recorded Dec 20, 1999
At 10:30 o'clock A. M
Janet M. Lamb
Reg. of Deeds, Presque Isle Co. MI

Register of Deeds Stamp & File Number

4. Lot No. _____, Recorded Plat _____

5. Private Claims _____

I, James A. Beck, in a field survey on Nov 19, 1999 do hereby state that under requirements of P.A. 74, Michigan P.A. of 1970, the corner points mentioned in lines 1 and 2 above were in conformance with regulations and rules therefore as required in the current manual of survey instructions of the United States Department of the Interior, Bureau of Land Management or by a decree of a Court of Law and for that the corner points mentioned in lines 3, 4 and 5 above were in conformance with the rules of the Michigan Board of Land Surveyors or by a Decree of a Court of Law, established, re-established, monumented, recovered, found as expressed below:

NOTE: Not more than 2 corners, all in the same town and range, may be recorded on this certificate.

	A	B	C	D	E	F	G	H	I	J	K	L	M
1													
2	6		5		4		3		2		1		
3													
4	7		8		9		10		11		12		
5													
6	10		17		16		15		14		13		
7													
8	19		20		21		22		23		24		
9													
10	30		29		28		27		26		25		
11													
12	31		32		33		34		35		36		
13													

A. Description of original monument and accessories and/or subsequent restoration:

D-13 1840 G.L.O. by John Hodgson (Twp. Boundary); "Set 1/4 Section post"; Aspen 24 N70°W 20; Maple 18, N50E 22

Feb. 16, 1976 P.A. 74 Recordation by Delmer E. Porter RLS 15410; Recorded as DI (T33N, R4E); Set 1/2" rod & cap 15410 and 4"x4" Cedar Stake Set by Single Proportion; N02°W 37.17' 16" Maple; S80°W 18.20' 10" Oak; S43°W 18.09' 7" Basswood

July 8, 1991; P.A. 132 Survey by Norman J. Quame P.S. 33984 "N1/4 Corner Section 5," (T33N, R4E)
"Set 1/2" rod & Cap" S43°W 18.09' 7" Basswood; S80°W 18.20' 10" Oak; Due West 5.93 M.P.

B. Description of corner evidence found and/or method applied in restoring or reestablishing corner:

D-13 November 19, 1999 Remonumentation by James A. Beck P.S. 21559; found P.S. 15410 cap on 1/2" iron rod in 1' +/- water of Lake Louise alongside of an iron fence post projecting 2' +/- above water and also alongside of a 4"x4" leaning wooden post; West 5.93' 1/2" iron rod and P.S. 15410 cap S80°W 18.20' 15410 tag in 1" Oak


in accordance with P.A. 345

Chairman Norman J. Quame

Date 12/14/99

C. Description of monument for corner and accessories established to perpetuate locating the position of the corner:

D-13 November 19, 1999 Remonumentation by James A. Beck P.S. 21559
P.S. 15410 cap on 1/2" iron rod in 1' +/- water of Lake Louise alongside of an iron fence post projecting 2' +/- above water and also alongside of a 4"x4" leaning wooden post; Witnesses: West 5.93' 1/2" iron rod and P.S. 15410 cap; S80°W 18.20' 15410 tag in 1" Oak; N8°W 15.82' P.S. 21559 tag in 3" W. Pine
S32°W 32.12' " " " " 4" W. Pine; S58°W 16.2 " " " " 1" W. Pine

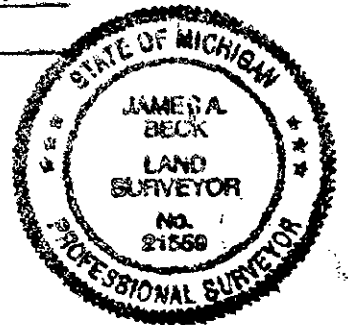

Signed by James A. Beck
Surveyor's Michigan License No. 21559

Date 12-18-1999