

8154

DEC 29 1999

LAND CORNER RECORDATION CERTIFICATE
Filing Requirement of Act 74, Mich. P.A. 1970

SECTION

For corners in

<u>Presque Isle</u> (County)	Located in:	Corner Code #
1. Public Land Survey	T34NR 4E	E-1 <input checked="" type="checkbox"/>
	T___ R___	_____
	T___ R___	_____
	T___ R___	_____
2. Property Controlling in Section	S___ T___ R___	_____
	S___ T___ R___	_____
3. Miscellaneous Property in Sec.	S___ T___ R___	_____
	S___ T___ R___	_____

Recorded Dec 16, 1999
 At 11:30 o'clock A. M
Janet M. Lamb
 Reg. of Deeds, Presque Isle Co. MI

Register of Deeds Stamp & File Number

4. Lot No. _____, Recorded Plat _____
 5. Private Claims _____

A	B	C	D	E	F	G	H	I	J	K	L	M
1												
2	6		5		4		3		2		1	
3												
4	7		8		9		10		11		12	
5												
6	18		17		16		15		14		13	
7												
8	19		20		21		22		23		24	
9												
10	30		29		28		27		26		25	
11												
12	31		32		33		34		35		36	
13												

I, Ronald Bischer, in a field survey on Aug. 18 19 99 do hereby state that under requirements of P.A. 74, Michigan P.A. of 1970, the corner points mentioned in lines 1 and 2 above were in conformance with regulations and rules therefore as required in the current manual of survey instructions of the United States Department of the Interior, Bureau of Land Management or by a decree of a Court of Law and/or that the corner points mentioned in lines 3, 4 and 5 above were in conformance with the rules of the Michigan Board of Land Surveyors or by a Decree of a Court of Law; established, re-established, monumented, recovered, found as expressed below:

NOTE: Not more than 2 corners, all in the same town and range, may be recorded on this certificate.

A. Description of original monument and accessories and/or subsequent restoration:

E-1					March 10, 1992
GLO Notes	1856				Norman Quaine #33984
N39° W	36 lks	6" Aspen			1/2" rod and cap #15410
N50° E	19 lks	6" Aspen			N45° W 24.03' 15" N. Pine
S32° W	34 lks	5" Aspen			S03° E 14.31' 15" N. Pine
S30° E	39 lks	5" W. Birch			S87° E 8.22' 13" N. Pine


B. Description of corner evidence found and/or method applied in restoring or reestablishing corner:

E-1		Found 1/2" rod and cap #15410
Aug. 18, 1999		and three Porter Witnesses as
Presque Isle County Remonumentation		mentioned above.
Ronald Bischer #22428		

C. Description of monument for corner and accessories established to perpetuate locating the position of the corner:

E-1
 1/2" Rod and cap #15410
 N45° W 24.03' 15" N. Pine
 S75° E 8.22' 13" N. Pine
 N06° E 14.25' 12" N. Pine
 S07° W 26.00' 13" N. Pine

Ratified by Peer Group
 in accordance with P.A. 345
 Chairman Norman J. Quaine
 Date 11/30/99

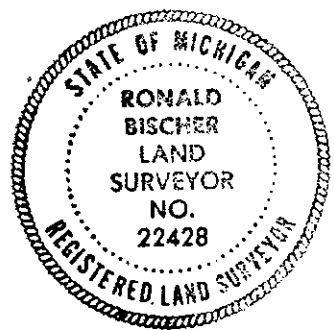

Signed by Ronald K. Bischer
 Surveyor's Michigan License No. 22428

Date 12-13-99