

1999 PRESQUE ISLE COUNTY REMONUMENTATION

LAND CORNER RECORDATION CERTIFICATE  
Filing Requirement of Act 74, Mich. P.A. 1970

DEC 29 1999

For corners in

Presque Isle  
(County)

Located In:

Corner Code #

- 1. Public Land Survey T<sup>34</sup> R<sup>4E</sup> E-3 ✓  
T\_\_\_ R\_\_\_  
T\_\_\_ R\_\_\_  
T\_\_\_ R\_\_\_
- 2. Property Controlling S\_\_\_ T\_\_\_ R\_\_\_  
in Section S\_\_\_ T\_\_\_ R\_\_\_
- 3. Miscellaneous S\_\_\_ T\_\_\_ R\_\_\_  
Property in Sec. S\_\_\_ T\_\_\_ R\_\_\_

SECTION

Recorded Dec. 16, 1999  
At 11:30 o'clock A.M.  
Janet M. Lamb  
Reg. of Deeds, Presque Isle Co. MI

Register of Deeds Stamp & File Number

- 4. Lot No. \_\_\_\_\_, Recorded Plat \_\_\_\_\_
- 5. Private Claims \_\_\_\_\_

I, Ronald Bischer, in a field survey on Aug. 18 1999 do hereby state that under requirements of P.A. 74, Michigan P.A. of 1970, the corner points mentioned in lines 1 and 2 above were in conformance with regulations and rules therefore as required in the current manual of survey instructions of the United States Department of the Interior, Bureau of Land Management or by a decree of a Court of Law and /or that the corner points mentioned in lines 3, 4 and 5 above were in conformance with the rules of the Michigan Board of Land Surveyors or by a Decree of a Court of Law; established, re-established, monumented, recovered, found as expressed below:

NOTE: Not more than 2 corners, all in the same town and range, may be recorded on this certificate.

A	B	C	D	E	F	G	H	I	J	K	L	M
1												
2	6		5		4		3		2		1	
3				●								
4	7		8		9		10		11		12	
5												
6	16		17		16		15		14		13	
7												
8	19		20		21		22		23		24	
9												
10	30		29		28		27		26		25	
11												
12	31		32		33		34		35		36	
13												

A. Description of original monument and accessories and/or subsequent restoration:

E-3  
1856 GLO Notes  
N65° E 12 lks 12" Spruce Pine  
S45° W 19 lks 12" Spruce Pine

Aug. 24, 1994  
Norman Quaine #33984  
found 1/2" rod and cap #18654  
S36° E 12.70' 14" Norway  
N31° E 13:93' 15" Aspen  
N34° W 15.40' Burnt Stump  
N51° W 25.38' 12" Norway

B. Description of corner evidence found and/or method applied in restoring or reestablishing corner:


E-3  
Aug. 18, 1999 Presque Isle Remonumentation  
Ronald Bischer #22428  
found 1/2" rod and cap #18654  
two old witnesses

C. Description of monument for corner and accessories established to perpetuate locating the position of the corner:

E-3  
1/2" rod and cap #18654

S35° E 12.70' 15" Red pine  
N34° W 15.40' Burnt Stump  
S82° E 18.21' 13" Aspen  
S10° W 70.87' 10" Twin Maple

Ratified by Peer Group  
in accordance with P.A. 345  
Chairman Norman Quaine  
Date 11/30/99

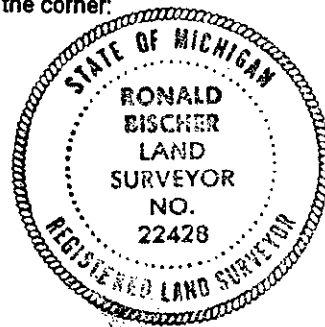

Signed by Ronald R. Bischer  
Surveyor's Michigan License No. 22428

Date 12-13-99