

DEC 29 1999

LAND CORNER RECORDATION CERTIFICATE  
Filing Requirement of Act 74, Mich. P.A. 1970

SECTION

For corners in

Presque Isle (County)	Located In:	Corner Code #
1. Public Land Survey	T 34N R 4E	E-4 ✓
	T ___ R ___	_____
	T ___ R ___	_____
	T ___ R ___	_____
2. Property Controlling in Section	S ___ T ___ R ___	_____
	S ___ T ___ R ___	_____
3. Miscellaneous Property in Sec.	S ___ T ___ R ___	_____
	S ___ T ___ R ___	_____

Recorded Dec. 16, 1999  
At 11:30 o'clock A. M.  
Janet M. Lamb  
Reg. of Deeds, Presque Isle Co. MI

Register of Deeds Stamp & File Number

4. Lot No. \_\_\_\_\_, Recorded Plat \_\_\_\_\_  
5. Private Claims \_\_\_\_\_

I, Ronald Bischer, in a field survey on Aug. 18, 1999 do hereby state that under requirements of P.A. 74, Michigan P.A. of 1970, the corner points mentioned in lines 1 and 2 above were in conformance with regulations and rules therefore as required in the current manual of survey instructions of the United States Department of the Interior, Bureau of Land Management or by a decree of a Court of Law and for that the corner points mentioned in lines 3, 4 and 5 above were in conformance with the rules of the Michigan Board of Land Surveyors or by a Decree of a Court of Law; established, re-established, monumented, recovered, found as expressed below:

	A	B	C	D	E	F	G	H	I	J	K	L	M
1													
2		6		5		4		3		2		1	
3													
4		7		8	●	9		10		11		12	
5													
6		18		17		16		15		14		13	
7													
8		19		20		21		22		23		24	
9													
10		30		29		28		27		26		25	
11													
12		31		32		33		34		35		36	
13													

NOTE: Not more than 2 corners, all in the same town and range, may be recorded on this certificate.

A. Description of original monument and accessories and/or subsequent restoration:

1856 GLO Notes  
East 2 lks 7" Spruce Pine  
S80°W 9 lks 4" Spruce

Oct. 6, 1987 Delmer Porter #15410  
2" pipe  
N16°W 14.10' 14" Norway  
S13°W 45.30' 10" J. Pine  
S59°E 16.32' 6" J. Pine

B. Description of corner evidence found and/or method applied in restoring or reestablishing corner:


E-4  
Aug. 18, 1999 Presque Isle County  
Remonumentation Ronald Bischer #22428

found 2" pipe placed 1/2" rod inside  
found three old witnesses

C. Description of monument for corner and accessories established to perpetuate locating the position of the corner:

E-4  
1/2" rod and cap inside 2" pipe #22428  
N11°W 14.10' 16" R. Pine  
N61°W 11.66' 9" R. Pine  
S13°W 17.57' 11" J. Pine  
S74°W 45.30' 11" R. Pine

Ratified by Peer Group  
in accordance with P.A. 345  
Chairman Norman J. Quinn  
Date 11/30/99

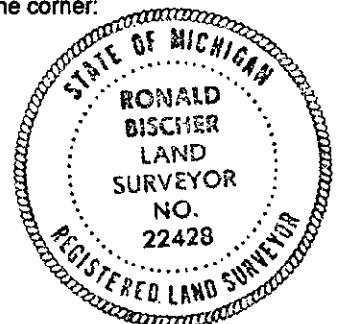

Signed by Ronald R. Bischer  
Surveyor's Michigan License No. 22428

Date 12-13-99