

8760

DEC 29 1999

LAND CORNER RECORDATION CERTIFICATE  
Filing Requirement of Act 74, Mich. P.A. 1970

SECTION

For corners in

Presque Isle (County)	Located In:	Corner Code #
1. Public Land Survey	T 34N, 4E	E-5 ✓
	T R	
	T R	
	T R	
2. Property Controlling in Section	S T R	
	S T R	
3. Miscellaneous Property in Sec.	S T R	
	S T R	


Recorded Dec. 16, 1999  
 At 11:30 o'clock A.M.  
*Janet M. Lamb*  
 Reg. of Deeds, Presque Isle Co. MI

Register of Deeds Stamp & File Number

4. Lot No. \_\_\_\_\_, Recorded Plat \_\_\_\_\_  
 5. Private Claims \_\_\_\_\_

I, Ronald Bischer, in a field survey on Aug. 19, 1999 do hereby state that under requirements of P.A. 74, Michigan P.A. of 1970, the corner points mentioned in lines 1 and 2 above were in conformance with regulations and rules therefore as required in the current manual of survey instructions of the United States Department of the Interior, Bureau of Land Management or by a decree of a Court of Law and /or that the corner points mentioned in lines 3, 4 and 5 above were in conformance with the rules of the Michigan Board of Land Surveyors or by a Decree of a Court of Law; established, re-established, monumented, recovered, found as expressed below:

NOTE: Not more than 2 corners, all in the same town and range, may be recorded on this certificate.

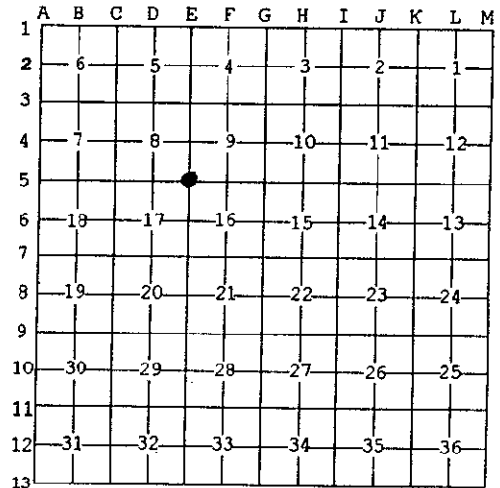

A. Description of original monument and accessories and/or subsequent restoration:

E-5  
 1856GLO Notes  
 N45°W 26 lks 7" Spruce pine  
 S60°E 46 lks 7" Spruce Pine

Oct. 6, 1987 Delmer Porter #15410  
 1/2" rod and cap #15410  
 West 12.71' 12" Norway  
 N57°W 42.42' 12" Oak  
 N75°E 10.08' 10" Oak

N0v. 6, 1987 Delmer porter #15410  
 1/2" rod and cap #15410  
 same witnesses as above


B. Description of corner evidence found and/or method applied in restoring or reestablishing corner:

E-5  
 Aug. 19, 1999 Presque Isle County Remonumentation  
 Ronald Bischer #22428  
 found 1/2" rod and cap #15410  
 found 3 old witnesses

C. Description of monument for corner and accessories established to perpetuate locating the position of the corner:

E-5  
 1/2" rod and cap #15410  
 N78°E 10.08' 14" Oak  
 N26°W 13.91' 12" Oak  
 N55°W 42.42' 14" Oak  
 West 12.71' 15" Red Pine

Ratified by Peer Group  
 in accordance with P.A. 345  
 Chairman *Norman J. Davis*  
 Date 11/30/99

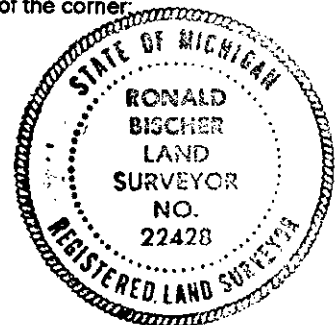

Signed by *Ronald R. Bischer*  
 Surveyor's Michigan License No. 22428

Date 12-13-99