

DEC 29 1999

LAND CORNER RECORDATION CERTIFICATE
Filing Requirement of Act 74, Mich. P.A. 1970

SECTION

For corners in

Table with columns: Located In: (Presque Isle County), Corner Code #, and survey details (Public Land Survey, Property Controlling, etc.)

Recorded Dec. 16, 1999
At 11:30 o'clock A.M.
Janet M. Lamb
Reg. of Deeds, Presque Isle Co. MI

Register of Deeds Stamp & File Number

4. Lot No. _____, Recorded Plat _____
5. Private Claims _____

Grid table with columns A-M and rows 1-13, containing numbers 1-36 and a central dot at row 6, column D.

I, Ronald Bischer, in a field survey on Aug. 19, 1999 do hereby state that under requirements of P.A. 74, Michigan P.A. of 1970, the corner points mentioned in lines 1 and 2 above were in conformance with regulations and rules therefore as required in the current manual of survey instructions of the United States Department of the Interior, Bureau of Land Management or by a decree of a Court of Law and/or that the corner points mentioned in lines 3, 4 and 5 above were in conformance with the rules of the Michigan Board of Land Surveyors or by a Decree of a Court of Law, established, re-established, monumented, recovered, found as expressed below.

NOTE: Not more than 2 corners, all in the same town and range, may be recorded on this certificate.

A. Description of original monument and accessories and/or subsequent restoration:

E-6
1856 GLO Notes
N62°W 19 lks 8" Spruce Pine
S30°E 4 lks 9" Spruce Pine
Oct. 6, 1987 Delmer Porter #15410
1/2" rod and cap #15410
N05°E 38.20' 6" Oak
S85°E 36.72' 6" Oak
S80°W 19.75' 12" Oak
Nov. 6, 1987 Delmer Porter #15410
1/2" rod and cap #15410
Same witnesses as above


B. Description of corner evidence found and/or method applied in restoring or reestablishing corner:

E-6
Aug. 19, 1999 Presque Isle County Remonumentation
Ronald Bischer #22428
found 1/2" rod and cap #15410
found 2 old witnesses

C. Description of monument for corner and accessories established to perpetuate locating the position of the corner:

E-6
1/2" rod and cap #15410
S82°W 19.70' 15" Oak
S83°E 36.72' 8" Oak
N50°E 38.22' 7" Oak
S34°W 28.24' 6" Oak

Ratified by Peer Group
in accordance with P.A. 345
Chairman [Signature]
Date 11/30/99

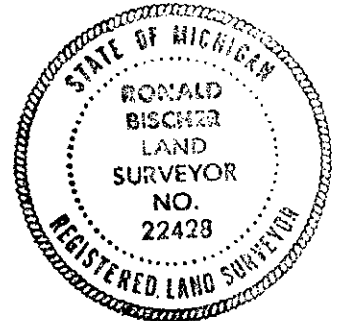

Signed by Ronald F. Bischer
Surveyor's Michigan License No. 22428

Date 12-13-99