

DEC 2 9 1999

SECTION

LAND CORNER RECORDATION CERTIFICATE
Filing Requirement of Act 74, Mich. P.A. 1970

For corners in

Presque Isle (County)	Located In:	Corner Code #
1. Public Land Survey	T 34 1R 4E	E-7 ✓
	T R	
	T R	
	T R	
2. Property Controlling in Section	S T R	
	S T R	
3. Miscellaneous Property in Sec.	S T R	
	S T R	

Recorded Dec. 16, 1999
 At 11:30 o'clock A.M.
Janet M. Lamb
 Reg. of Deeds, Presque Isle Co. MI

Register of Deeds Stamp & File Number

4. Lot No. _____, Recorded Plat _____
 5. Private Claims _____

I, Ronald Bischer, in a field survey on Aug 19, 1999 do hereby state that under requirements of P.A. 74, Michigan P.A. of 1970, the corner points mentioned in lines 1 and 2 above were in conformance with regulations and rules therefore as required in the current manual of survey instructions of the United States Department of the Interior, Bureau of Land Management or by a decree of a Court of Law and for that the corner points mentioned in lines 3, 4 and 5 above were in conformance with the rules of the Michigan Board of Land Surveyors or by a Decree of a Court of Law; established, re-established, monumented, recovered, found as expressed below:

	A	B	C	D	E	F	G	H	I	J	K	L	M
1													
2	6		5		4		3		2		1		
3													
4	7		8		9		10		11		12		
5													
6	18		17		16		15		14		13		
7													
8	19		20		21		22		23		24		
9													
10	30		29		28		27		26		25		
11													
12	31		32		33		34		35		36		
13													

NOTE: Not more than 2 corners, all in the same town and range, may be recorded on this certificate.

A. Description of original monument and accessories and/or subsequent restoration:

E-7
 1856 GLO Notes
 N32° E 27 lks 6" Spruce Pine
 S20° W 51 lks 8" Spruce pine

Feb 25, 1986 Delmer Porter #15410
 found sq. stake and 8" spike @ fence
 corner set 1/2" rod in place
 N56° W 23.60' 4" twin maple
 S57° E 9.39' 8" oak
 S51° W 17.31' 10" Oak


B. Description of corner evidence found and/or method applied in restoring or reestablishing corner:

E-7
 Aug. 19, 1999 Presque Isle County Remonumentation
 Ronald Bischer #22428
 found 1/2" rod and cap #15410
 found three old witnesses

C. Description of monument for corner and accessories established to perpetuate locating the position of the corner:

E-7
 1/2" rod and cap #15410
 N53° W 23.60' 7" Twin maple
 S54° W 17.31' 10" Oak
 S53° E 9.39' 10" Oak
 N41° E 40.70' 21" Oak

Ratified by Peer Group
 in accordance with P.A. 345
 Chairman Norman J. Quani
 Date 11/30/99

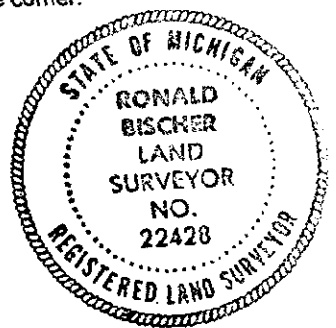

Signed by Ronald B. Bischer
 Surveyor's Michigan License No. 22428

Date 12-13-99