

DEC 29 1999

1999 Presque Isle County Remonumentation

LAND CORNER RECORDATION CERTIFICATE  
Filing Requirement of Act 74, Mich. P.A. 1970

SECTION

For corners in

<u>Presque Isle</u> (County)	Located In:	Corner Code #
1. Public Land Survey	<u>B4N R 4E</u>	<u>E-10</u> ✓
	T <u>    </u> R <u>    </u>	<u>    </u>
	T <u>    </u> R <u>    </u>	<u>    </u>
	T <u>    </u> R <u>    </u>	<u>    </u>
2. Property Controlling in Section	S <u>    </u> T <u>    </u> R <u>    </u>	<u>    </u>
	S <u>    </u> T <u>    </u> R <u>    </u>	<u>    </u>
3. Miscellaneous Property in Sec.	S <u>    </u> T <u>    </u> R <u>    </u>	<u>    </u>
	S <u>    </u> T <u>    </u> R <u>    </u>	<u>    </u>

Recorded Dec 16, 1999  
 At 11:30 o'clock A.M.  
*Janet M. Lamb*  
 Reg. of Deeds, Presque Isle Co. MI

Register of Deeds Stamp & File Number

4. Lot No. \_\_\_\_\_, Recorded Plat \_\_\_\_\_  
 5. Private Claims \_\_\_\_\_

I, Ronald Bischer, in a field survey on Aug 20, 1999 do hereby state that under requirements of P.A. 74, Michigan P.A. of 1970, the corner points mentioned in lines 1 and 2 above were in conformance with regulations and rules therefore as required in the current manual of survey instructions of the United States Department of the Interior, Bureau of Land Management or by a decree of a Court of Law and /or that the corner points mentioned in lines 3, 4 and 5 above were in conformance with the rules of the Michigan Board of Land Surveyors or by a Decree of a Court of Law; established, re-established, monumented, recovered, found as expressed below:

A	B	C	D	E	F	G	H	I	J	K	L	M
1												
2	6	5	4	3	2	1						
3												
4	7	8	9	10	11	12						
5												
6	18	17	16	15	14	13						
7												
8	19	20	21	22	23	24						
9												
10	30	29	28	27	26	25						
11												
12	31	32	33	34	35	36						
13												

NOTE: Not more than 2 corners, all in the same town and range, may be recorded on this certificate.

A. Description of original monument and accessories and/or subsequent restoration:

E-10  
 1856 GLO Notes  
 S85°W 18 lks 10" Tamarack  
 N40°E 30 lks 9" Tamarack

Aug. 1, 1980 Danny Bongiovanni #24586 found 1/2" rod  
 S60°W 18.65' 10" Fir  
 N85°W 6.15' 8" Fir  
 N08°W 12.60' 10" W. Pine  
 March 25, 1994 Ronald Bischer #22428 found 1/2" rod  
 found 2 old witnesses  
 set 3 new witnesses


B. Description of corner evidence found and/or method applied in restoring or reestablishing corner:

E-10  
 Aug. 20, 1999 Presque Isle County Remonumentation  
 Ronald Bischer #22428  
 found three old witnesses  
 found 1/2" rod and cap #22428

C. Description of monument for corner and accessories established to perpetuate locating the position of the corner:

E-10  
 1/2" rod and cap #22428  
 N08°W 12.60' 18" W. Pine  
 N83°E 7.55' 8" Balsam  
 S62°W 33.35' 8" Balsam  
 S08°E 16.98' 7" Balsam  
 N65°W 45.45' Pine Stub

Ratified by Peer Group  
 in accordance with P.A. 345  
 Chairman *Norman J. Pusnie*  
 Date 11/30/99

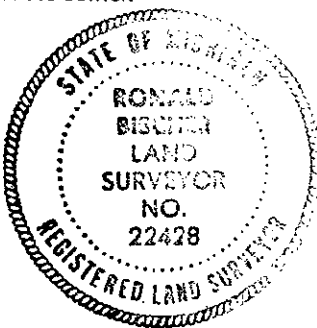

Signed by Ronald E. Bischer  
 Surveyor's Michigan License No. 22428

Date 12-13-99