

8769

DEC 29 1999

1999 PRESQUE ISLE COUNTY REMONUMENTATION

LIBER 335 PAGE 172 SECTION

LAND CORNER RECORDATION CERTIFICATE
Filing Requirement of Act 74, Mich. P.A. 1970

For corners in

Table with columns: Located In: (Presque Isle County), Corner Code #, and survey types (1. Public Land Survey, 2. Property Controlling in Section, 3. Miscellaneous Property in Sec.)

Recorded Dec. 16, 1999
At 11:30 o'clock A M
Janet M. Lamb
Reg. of Deeds, Presque Isle Co. MI

Register of Deeds Stamp & File Number

4. Lot No. , Recorded Plat
5. Private Claims

I, Ronald Bischer, in a field survey on Aug. 20, 1999 do hereby state that under requirements of P.A. 74, Michigan P.A. of 1970, the corner points mentioned in lines 1 and 2 above were in conformance with regulations and rules therefore as required in the current manual of survey instructions of the United States Department of the Interior, Bureau of Land Management or by a decree of a Court of Law and/or that the corner points mentioned in lines 3, 4 and 5 above were in conformance with the rules of the Michigan Board of Land Surveyors or by a Decree of a Court of Law; established, re-established, monumented, recovered, found as expressed below.

NOTE: Not more than 2 corners, all in the same town and range, may be recorded on this certificate.

Grid table with columns A-M and rows 1-13, containing numbers 1-36.

A. Description of original monument and accessories and/or subsequent restoration:

E-13
1840 GLO Notes
N63°W 20 lks 6" Elm
N50°E 38 lks 24" Aspen

1969 Delmer Porter #15410
1/2" rod and cap replaced w/ conc mon
S85°W 49.30' 12" Norway
S10°E 21.00' 7" Norway
S83°E 49.80' 6" Norway
Sept. 5, 1995 Norman Quaine #33984
conc. mon. by cedar post
N83°E 50.17' 8" norway
S05°E 21.32' 13" Norway
S77°E 40.95' 12" W. Pine
S55°E 16.37' Twin 9" Cedar


B. Description of corner evidence found and/or method applied in restoring or reestablishing corner:

E-13
Aug. 20, 1999 Presque Isle County Remonumentation
Ronald Bischer #22428
found conc mon
found four witnesses

C. Description of monument for corner and accessories established to perpetuate locating the position of the corner:

E-13
Conc. Mon.
S05°E 21.00' 11" R. Pine
S54°E 16.31' 10" Cedar
S76°E 41.00' 10" W. Pine
N82°E 50.20' 9" R. Pine

Ratified by Peer Group
in accordance with P.A. 345
Chairman Norman Quaine
Date 11/30/99

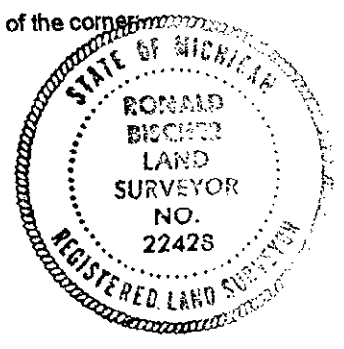

Signed by Ronald R. Bischer
Surveyor's Michigan License No. 22428

Date 12-13-99