

DEC 23 1999

SECTION

LAND CORNER RECORDATION CERTIFICATE
Filing Requirement of Act 74, Mich. P.A. 1970

For corners in

<u>Presque Isle</u> (County)	Located In:	Corner Code #
1. Public Land Survey	<u>T4N R4E</u>	<u>F-1</u> ✓
	T ___ R ___	_____
	T ___ R ___	_____
	T ___ R ___	_____
2. Property Controlling in Section	S ___ T ___ R ___	_____
	S ___ T ___ R ___	_____
3. Miscellaneous Property in Sec.	S ___ T ___ R ___	_____
	S ___ T ___ R ___	_____

Recorded Dec. 16, 1999
 At 11:30 o'clock A.M.
Janet M. Lamb
 Reg. of Deeds, Presque Isle Co. MI

Register of Deeds Stamp & File Number

4. Lot No. _____, Recorded Plat _____
 5. Private Claims _____

I, Ronald Bischer, in a field survey on Aug. 18, 1999 do hereby state that under requirements of P.A. 74, Michigan P.A. of 1970, the corner points mentioned in lines 1 and 2 above were in conformance with regulations and rules therefore as required in the current manual of survey instructions of the United States Department of the Interior, Bureau of Land Management or by a decree of a Court of Law and /or that the corner points mentioned in lines 3, 4 and 5 above were in conformance with the rules of the Michigan Board of Land Surveyors or by a Decree of a Court of Law; established, re-established, monumented, recovered, found as expressed below:

NOTE: Not more than 2 corners, all in the same town and range, may be recorded on this certificate.

A	B	C	D	E	F	G	H	I	J	K	L	M
1												
2	6		5		4		3		2		1	
3												
4	7		8		9		10		11		12	
5												
6	18		17		16		15		14		13	
7												
8	19		20		21		22		23		24	
9												
10	30		29		28		27		26		25	
11												
12	31		32		33		34		35		36	
13												

A. Description of original monument and accessories and/or subsequent restoration:

F-1
 1840 GLO Notes
 N71°E 34 lks 18" W. Pine
 N64°W 56 lks 24" W. Pine

March 10, 1992 Norman Quaine #33984
 Set 1/2" rod by S.P. and cap #15410
 N19°E 21.64' 4" Spruce
 N34°W 39.05' 4" Maple
 N48°E 6.70' 4" Maple
 N63°E 11.30' 5" Maple


B. Description of corner evidence found and/or method applied in restoring or reestablishing corner:

F-1
 Aug. 18, 1999 Presque Isle County Remonumentation
 Ronald Bischer #22428
 1/2" rod and cap #15410
 found no witnesses

Ratified by Peer Group
 in accordance with P.A. 345
 Chairman Norman J. Quaine
 Date 11/30/99

C. Description of monument for corner and accessories established to perpetuate locating the position of the corner:

F-1
 1/2" rod and cap #15410
 S10°W 38.23' 12" J. Pine
 S34°E 52.55' 18" R. Pine
 S46°E 41.68' 17" R. Pine
 N41°E 22.97' 24" R. Pine

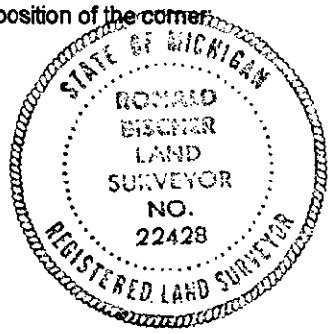

Signed by Ronald R. Bischer
 Surveyor's Michigan License No. 22428

Date 12-13-99