

LAND CORNER RECORDATION CERTIFICATE
Filing Requirement of Act 74, Mich. P.A. 1970

For corners in

<u>Presque Isle</u> (County)	Located In:	Corner Code #
1. Public Land Survey	T <u>34</u> N <u>4</u> E	G-4
	T ___ R ___	_____
	T ___ R ___	_____
	T ___ R ___	_____
2. Property Controlling in Section	S ___ T ___ R ___	_____
	S ___ T ___ R ___	_____
3. Miscellaneous Property in Sec.	S ___ T ___ R ___	_____
	S ___ T ___ R ___	_____

PRESQUE ISLE COUNTY
RECORDED

98 DEC 17 PM 4:25

Jane M. Lamb
REGISTER OF DEEDS

Register of Deeds Stamp & File Number

4. Lot No. _____, Recorded Plat _____
5. Private Claims _____

I, Delmer E. Porter in a field survey on July 2, 1998 do hereby state that under requirements of P.A. 74, Michigan P.A. of 1970, the corner points mentioned in lines 1 and 2 above were in conformance with regulations and rules therefore as required in the current manual of survey instructions of the United States Department of the Interior, Bureau of Land Management or by a decree of a Court of Law and for that the corner points mentioned in lines 3, 4 and 5 above were in conformance with the rules of the Michigan Board of Land Surveyors or by a Decree of a Court of Law; established, re-established, monumented, recovered, found as expressed below:

NOTE: Not more than 2 corners, all in the same town and range, may be recorded on this certificate.

A	B	C	D	E	F	G	H	I	J	K	L	M
1												
2	6	5			4		3		2		1	
3												
4	7	8			9	●	10		11		12	
5												
6	10	17			16		15		14		13	
7												
8	19	20			21		22		23		24	
9												
10	30	29			28		27		26		25	
11												
12	31	32			33		34		35		36	
13												

A. Description of original monument and accessories and/or subsequent restoration:

G-4 GLO NOTES
June 26, 1856
Set Quarter Sec Post
Spruce 6 N55E 22 Links
Spruce 7 S36W 15 Links
Old Quarter Cor 90 East
Effaced Tami 8 S58W 6
Do 8 East 8

SURVEY &
REMONUMENTATION

JAN 14 1999


B. Description of corner evidence found and/or method applied in restoring or reestablishing corner:

G-4 Set 1/2" Rod & Cap #15410
By Single Proportion
80' E of Existing Fence Cor
N19°W 16.90' 6" Cedar
N40°E 27.90' 12" Cedar
S34°W 15.42' 10" Pine

SECTION

C. Description of monument for corner and accessories established to perpetuate locating the position of the corner:

G-4 1/2" Rod & Cap #15410
N19°W 16.90' 6" Cedar
N40°E 27.90' 12" Cedar
S34°W 15.42' 10" Spruce
S55°E 46.42' 10" Spruce
80' E of Existing FE Corner

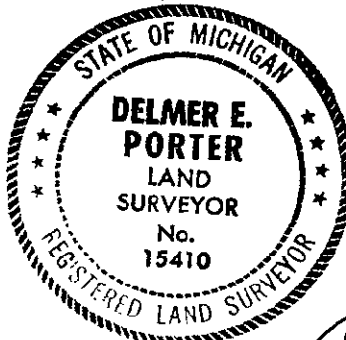

Ratified by Peer Group
in accordance with P.A. 345

Chairman *Norman J. Quinn*
Date 12/17/98

Signed by *Delmer E. Porter*
Surveyor's Michigan License No. #15410

Date Dec 9, 1998