

2510

LAND CORNER RECORDATION CERTIFICATE
Filing Requirement of Act 74, Mich. P.A. 1970

For corners in

<u>Presque Isle</u> (County)	Located in:	Corner Code #
1. Public Land Survey	T <u>34N</u> R <u>4E</u>	<u>G-6</u>
	T _____ R _____	_____
	T _____ R _____	_____
	T _____ R _____	_____
2. Property Controlling in Section	S _____ T _____ R _____	_____
	S _____ T _____ R _____	_____
3. Miscellaneous Property in Sec.	S _____ T _____ R _____	_____
	S _____ T _____ R _____	_____

PRESQUE ISLE COUNTY
RECORDED

98 DEC 17 PH 4: 26

Janet M. Lamb
REGISTER OF DEEDS

Register of Deeds Stamp & File Number

4. Lot No. _____, Recorded Plat _____
5. Private Claims _____

I, Delmer E. Porter, in a field survey on July 2, 1998 do hereby state that under requirements of P.A. 74, Michigan P.A. of 1970, the corner points mentioned in lines 1 and 2 above were in conformance with regulations and rules therefore as required in the current manual of survey instructions of the United States Department of the Interior, Bureau of Land Management or by a decree of a Court of Law and /or that the corner points mentioned in lines 3, 4 and 5 above were in conformance with the rules of the Michigan Board of Land Surveyors or by a Decree of a Court of Law; established, re-established, monumented, recovered, found as expressed below:

NOTE: Not more than 2 corners, all in the same town and range, may be recorded on this certificate.

	A	B	C	D	E	F	G	H	I	J	K	L	M
1													
2	6		5		4		3		2		1		
3													
4	7		8		9		10		11		12		
5													
6	18		17		16		15		14		13		
7													
8	19		20		21		22		23		24		
9													
10	30		29		28		27		26		25		
11													
12	31		32		33		34		35		36		
13													

A. Description of original monument and accessories and/or subsequent restoration:

G-6 GLO NOTES
June 27, 1856
Set Quarter Sec. Post
Spruces N67E 19 Links
Spruces S50W 34 Links

SURVEY &
REMONUMENTATION

JAN 14 1999


SECTION

B. Description of corner evidence found and/or method applied in restoring or reestablishing corner:

G-6 1/2" Rod & LLS Cap
Fence N&S 65' East
S47°W 28.62' 4" Balsam
S29°E 25.94' 4" Balsam
N80°E 32.58' 5" Balsam

C. Description of monument for corner and accessories established to perpetuate locating the position of the corner:

G-6 1/2" Rod & Cap #15410
S30°E 25.93' 6" Spruce
S47°W 28.60' 4" Spruce
N89°E 32.54' 6" Spruce
N12°E 49.83' 6" Cedar
Set 3" Spruce Post 5' Tall
0.5' East of Corner
67' E of Single Wire N-S FE

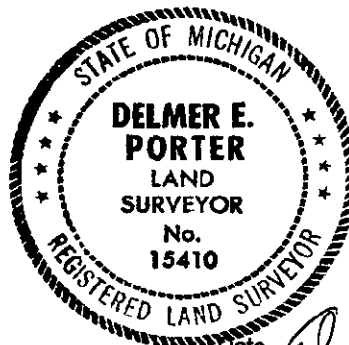

Ratified by Peer Group
in accordance with P.A. 345

Chairman *Norman J. Quinn*
Date 12/17/98

Signed by Delmer E. Porter
Surveyor's Michigan License No. #15410

Date Dec 9, 1998