

2511

1998 PRESQUE ISLE COUNTY, STATE OF MICHIGAN REMONUMENTATION

LAND CORNER RECORDATION CERTIFICATE
Filing Requirement of Act 74, Mich. P.A. 1970

LIBER 329 PAGE 879

For corners in

Presque Isle (County)	Located In:	Corner Code #
1. Public Land Survey	T 34N R 4E	G-7
	T R	
	T R	
	T R	
2. Property Controlling in Section	S T R	
	S T R	
3. Miscellaneous Property in Sec.	S T R	
	S T R	

PRESQUE ISLE COUNTY
RECORDED

98 DEC 17 PM 4:26

Janet M. Lamb
REGISTER OF DEEDS

Register of Deeds Stamp & File Number

4. Lot No. _____, Recorded Plat _____
5. Private Claims _____

I, Delmer E. Porter in a field survey on Jan. 14, 1998 do hereby state that under requirements of P.A. 74, Michigan P.A. of 1970, the corner points mentioned in lines 1 and 2 above were in conformance with regulations and rules therefore as required in the current manual of survey instructions of the United States Department of the Interior, Bureau of Land Management or by a decree of a Court of Law and/or that the corner points mentioned in lines 3, 4 and 5 above were in conformance with the rules of the Michigan Board of Land Surveyors or by a Decree of a Court of Law; established, re-established, monumented, recovered, found as expressed below.

NOTE: Not more than 2 corners, all in the same town and range, may be recorded on this certificate.

	A	B	C	D	E	F	G	H	I	J	K	L	M
1													
2	6		5		4		3		2		1		
3													
4	7		8		9		10		11		12		
5													
6	18		17		16		15		14		13		
7													
8	19		20		21		22		23		24		
9													
10	30		29		28		27		26		25		
11													
12	31		32		33		34		35		36		
13													

A. Description of original monument and accessories and/or subsequent restoration:

G-7 GLO NOTES
June 26, 1856
Set Post Corner of
Sec. 15&16, 21&22
Y Pine 14 S22E 40 Links
Y Pine 14 N60W 28 Links

SURVEY &
REMONUMENTATION

JAN 14 1999


SECTION

B. Description of corner evidence found and/or method applied in restoring or reestablishing corner:

G-7 1/2" Rod X 24" Rerod
S68°E 11.16' 5" Oak
N78°W 32.62' 6" Oak
N14°E 23.81' 5" Oak

C. Description of monument for corner and accessories established to perpetuate locating the position of the corner:

G-7 1/2" Rod & Cap #15410
And 3"X3" Cedar Post
N14°E 23.77' 6" Oak
S68°E 11.12' 6" Oak
S47°W 41.29' 4" Maple
N78°W 32.62' 8" Oak

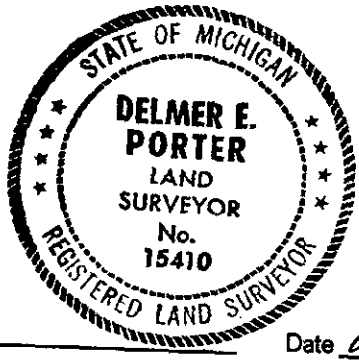

Ratified by Peer Group
in accordance with P.A. 345

Chairman *Norman J. Quinn*
Date 12/17/98

Signed by *Delmer E. Porter*
Surveyor's Michigan License No. #15410

Date Dec 9, 1998