

2515

1998 PRESQUE ISLE COUNTY, STATE OF MICHIGAN REMONUMENTATION

LAND CORNER RECORDATION CERTIFICATE
Filing Requirement of Act 74, Mich. P.A. 1970

For corners in

Presque Isle (County)	Located In:	Corner Code #
1. Public Land Survey	T 34N 4E	G-11
	T R	
	T R	
	T R	
2. Property Controlling in Section	S T R	
	S T R	
3. Miscellaneous Property in Sec.	S T R	
	S T R	

PRESQUE ISLE COUNTY
RECORDED

98 DEC 17 PM 4:26

Janet M. Lamb
REGISTER OF DEEDS

Register of Deeds Stamp & File Number

4. Lot No. _____, Recorded Plat _____
5. Private Claims _____

	A	B	C	D	E	F	G	H	I	J	K	L	M
1													
2	6		5		4		3		2		1		
3													
4	7		8		9		10		11		12		
5													
6	18		17		16		15		14		13		
7													
8	19		20		21		22		23		24		
9													
10	30		29		28		27		26		25		
11													
12	31		32		33		34		35		36		
13													

I, Delmer E. Porter in a field survey on Jan. 9, 1998 do hereby state that under requirements of P.A. 74, Michigan P.A. of 1970, the corner points mentioned in lines 1 and 2 above were in conformance with regulations and rules therefore as required in the current manual of survey instructions of the United States Department of the Interior, Bureau of Land Management or by a decree of a Court of Law and/or that the corner points mentioned in lines 3, 4 and 5 above were in conformance with the rules of the Michigan Board of Land Surveyors or by a Decree of a Court of Law; established, re-established, monumented, recovered, found as expressed below:

NOTE: Not more than 2 corners, all in the same town and range, may be recorded on this certificate.

A. Description of original monument and accessories and/or subsequent restoration:

G-11 GLO Notes	R.S. Scott & Assoc.
June 27, 1856	1960 Witness
Set Post Corner of	"T" Iron
Sec 27&28, 33&34	N55°E 77.89' P. Pole
Sugar 16 N32°E 12 Links	S45°E 82.58' 6" Aspen
Sugar 8 S45W 31 Links	


B. Description of corner evidence found and/or method applied in restoring or reestablishing corner:

G-11 1/2" Rod & Cap in Mon. Box
N65°E 77.88' P. Pole

Ratified by Peer Group
in accordance with P.A. 345
Chairman *Norman J. Quinn*
Date 12/17/98

C. Description of monument for corner and accessories established to perpetuate locating the position of the corner:

G-11 1/2" Rod & Cap #15410
N71°E 77.64' #HK445 T Pole
S56°E 85.03' T Pole
S46°E 67.16' N End of R/W Marker
S40°W 50.95' 7" Aspen

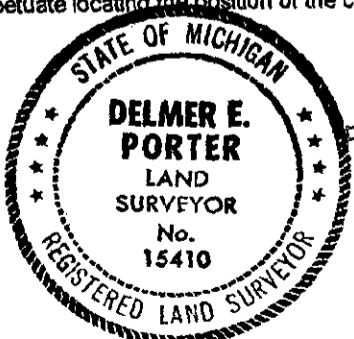

SURVEY & REMONUMENTATION

JAN 14 1999

SECTION

Signed by *Delmer E. Porter*
Surveyor's Michigan License No. #15410

Date Dec 9, 1998