

2516

1998 PRESQUE ISLE COUNTY, STATE OF MICHIGAN REMONUMENTATION

LIBER 329 PAGE 884

LAND CORNER RECORDATION CERTIFICATE
Filing Requirement of Act 74, Mich. P.A. 1970

For corners in

Presque Isle
(County)

Located in:

Corner Code #

1. Public Land Survey

T	34R	4E	G-12
T	_____	_____	_____
T	_____	_____	_____
T	_____	_____	_____
S	T	R	_____
S	T	R	_____
S	T	R	_____
S	T	R	_____

2. Property Controlling in Section

3. Miscellaneous Property in Sec.

4. Lot No. _____, Recorded Plat _____

5. Private Claims _____

PRESQUE ISLE COUNTY
RECORDED

98 DEC 17 PM 4:26

Janet M. Lamb
REGISTER OF DEEDS

Register of Deeds Stamp & File Number

I, Delmer E. Porter, in a field survey on Jan. 9, 1998 do hereby state that under requirements of P.A. 74, Michigan P.A. of 1970, the corner points mentioned in lines 1 and 2 above were in conformance with regulations and rules therefore as required in the current manual of survey instructions of the United States Department of the Interior, Bureau of Land Management or by a decree of a Court of Law and/or that the corner points mentioned in lines 3, 4 and 5 above were in conformance with the rules of the Michigan Board of Land Surveyors or by a Decree of a Court of Law; established, re-established, monumented, recovered, found as expressed below:

NOTE: Not more than 2 corners, all in the same town and range, may be recorded on this certificate.

1	A	B	C	D	E	F	G	H	I	J	K	L	M
2		6		5		4		3		2		1	
3													
4		7		8		9		10		11		12	
5													
6		19		17		16		15		14		13	
7													
8		19		20		21		22		23		24	
9													
10		30		29		28		27		26		25	
11													
12		31		32		33		34		35		36	
13													

A. Description of original monument and accessories and/or subsequent restoration:

G-12 GLO Notes
Set Quarter Sec Post
Cedar 8 S35W 23 Links
Cedar 8 N45E 11 Links

Location confirmed by
Henry Rasche
N40°E 17.35' 12" Cedar
S75°E 6.55' 12" Cedar
S10°E 9.83' 16" Cedar
17' E of Center of Stream/ Old Log Rd.


B. Description of corner evidence found and/or method applied in restoring or reestablishing corner:

G-12 Set 1/2" Rod & Cap
N44°E 17.35' 12" Cedar
S59°E 6.55' 12" Cedar
S17°E 9.83' 16" Cedar

Ratified by Peer Group
in accordance with P.A. 345
Chairman *Norman J. Quinn*
Date 12/17/98

C. Description of monument for corner and accessories established to perpetuate locating the position of the corner:

G-12 1/2" Rod & Cap #22429
N37°W 8.87' 7" Cedar
N47°E 17.69' 12" Cedar
S55°E 7.11' 13" Cedar
S16°E 10.19' 13" Cedar

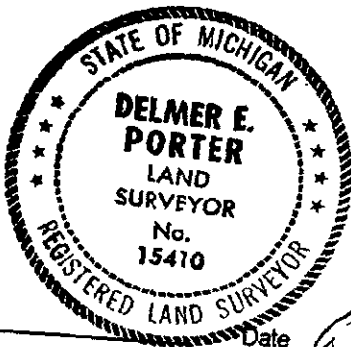

SURVEY &
REMONUMENTATION
JAN 14 1999
SECTION

Signed by *Delmer E. Porter*
Surveyor's Michigan License No. #15410

Date Dec 9, 1998