

2518

1998 PRESQUE ISLE COUNTY, STATE OF MICHIGAN REMONUMENTATION

LAND CORNER RECORDATION CERTIFICATE
Filing Requirement of Act 74, Mich. P.A. 1970

For corners in

<u>Presque Isle</u> (County)	Located in:	Corner Code #
1. Public Land Survey	<u>B4N R4E</u>	<u>H-1</u>
	T <u> </u> R <u> </u>	<u> </u>
	T <u> </u> R <u> </u>	<u> </u>
	T <u> </u> R <u> </u>	<u> </u>
2. Property Controlling in Section	S <u> </u> T <u> </u> R <u> </u>	<u> </u>
	S <u> </u> T <u> </u> R <u> </u>	<u> </u>
3. Miscellaneous Property in Sec.	S <u> </u> T <u> </u> R <u> </u>	<u> </u>
	S <u> </u> T <u> </u> R <u> </u>	<u> </u>

PRESQUE ISLE COUNTY
RECORDED

98 DEC 17 PM 4: 27

Janet M. Lamb
REGISTER OF DEEDS

Register of Deeds Stamp & File Number

4. Lot No. _____, Recorded Plat _____
5. Private Claims _____

I, Delmer E. Porter in a field survey on July 2, 1998 do hereby state that under requirements of P.A. 74, Michigan P.A. of 1970, the corner points mentioned in lines 1 and 2 above were in conformance with regulations and rules therefore as required in the current manual of survey instructions of the United States Department of the Interior, Bureau of Land Management or by a decree of a Court of Law and/or that the corner points mentioned in lines 3, 4 and 5 above were in conformance with the rules of the Michigan Board of Land Surveyors or by a Decree of a Court of Law, established, re-established, monumented, recovered, found as expressed below:

NOTE: Not more than 2 corners, all in the same town and range, may be recorded on this certificate.

A	B	C	D	E	F	G	H	I	J	K	L	M
1												
2	6		5			4		3		2		1
3												
4	7		8			9		10		11		12
5												
6	18		17			16		15		14		13
7												
8	19		20			21		22		23		24
9												
10	30		29			28		27		26		25
11												
12	31		32			33		34		35		36
13												

A. Description of original monument and accessories and/or subsequent restoration:

H-1 GLO NOTES - Set North corn.
Sugar 9 N78W 7
Sugar 10 N61E 2
N1°.36'W 9.95 Beach 8
Old Cor 291 North & 160 West
Beech 24 N59E 30
Do 6 N50W 19
Effaced

B. Description of corner evidence found and/or method applied in restoring or reestablishing corner:

H-1 1/2" Pipe
N73°.W 22.75' 9" Spruce
East 0.33' Fence Corner


SURVEY &
REMONUMENTATION

JAN 14 1999

SECTION

C. Description of monument for corner and accessories established to perpetuate locating the position of the corner:

H-1 1/2" Pipe
N72°.E 23.78' 5" Aspen
N90°.E 0.88' FE Post
S06°.W 20.10' 5" Aspen
N72°.W 42.00' 12" Spruce
Near 4"X4" Square Post

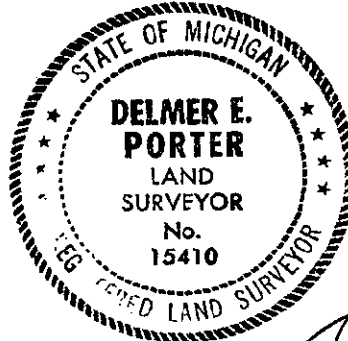

Ratified by Peer Group
in accordance with P.A. 345
Chairman *Norman J. Quinn*
Date 12/17/98

Signed by *Delmer E. Porter*
Surveyor's Michigan License No. #15410

Date Dec 9, 1998