

1998 PRESQUE ISLE COUNTY, STATE OF MICHIGAN REMONUMENTATION

LAND CORNER RECORDATION CERTIFICATE
Filing Requirement of Act 74, Mich. P.A. 1970

For corners in

Presque Isle (County)	Located In:	Corner Code #
1. Public Land Survey	T34NR 4E	H-7
	T R	
	T R	
	T R	
2. Property Controlling in Section	S T R	
	S T R	
3. Miscellaneous Property in Sec.	S T R	
	S T R	

PRESQUE ISLE COUNTY
RECORDED

98 DEC 17 PM 4: 27

Janet M. Lamb
REGISTER OF DEEDS

Register of Deeds Stamp & File Number

4. Lot No. _____, Recorded Plat _____
5. Private Claims _____

I, Delmer E. Porter in a field survey on Jan. 9, 1998 do hereby state that under requirements of P.A. 74, Michigan P.A. of 1970, the corner points mentioned in lines 1 and 2 above were in conformance with regulations and rules therefore as required in the current manual of survey instructions of the United States Department of the Interior, Bureau of Land Management or by a decree of a Court of Law and /or that the corner points mentioned in lines 3, 4 and 5 above were in conformance with the rules of the Michigan Board of Land Surveyors or by a Decree of a Court of Law; established, re-established, monumented, recovered, found as expressed below:

NOTE: Not more than 2 corners, all in the same town and range, may be recorded on this certificate.

	A	B	C	D	E	F	G	H	I	J	K	L	M
1													
2	6		5		4		3		2		1		
3													
4	7		8		9		10		11		12		
5													
6	18		17		16		15		14		13		
7													
8	19		20		21		22		23		24		
9													
10	30		29		28		27		26		25		
11													
12	31		32		33		34		35		36		
13													

A. Description of original monument and accessories and/or subsequent restoration:

H-7 GLO Notes	1/2" Rod & LLS Cap	1/2" X 24" Rerod
June 26, 1856	N28°W 23.18' 6" Aspen	N22°E 11.48' 5" Oak
Set Quarter Sec. Post	N21°E 19.74' 10" Tw Oak	S08°W 22.43' 8" oak
Y Pine 20 N80E 41 Lks	S61°E 19.37' 7" Oak	S31°W 24.26' 4" Maple
Y Pine 20 S60°W 56 Lks.		

B. Description of corner evidence found and/or method applied in restoring or reestablishing corner:

H-7 1/2" Rod & Cap #33984
N24°W 24.14' 8" Aspen
N23°E 20.22' 10" Tw. Oak
S59°E 18.55' 8" Oak
S02°E 25.56' 6" Oak


SURVEY &
REMONUMENTATION

JAN 14 1999

SECTION

C. Description of monument for corner and accessories established to perpetuate locating the position of the corner:

H-7 1/2" Rod & 3"X3" Sq. Stake Scribed 1/4
N24°W 24.14' 8" Aspen
N23°E 20.22' 10" Twin Oak
S59°E 18.55' 8" Oak
S02°E 25.56' 6" Oak

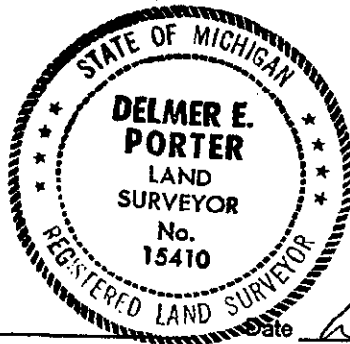

Ratified by Peer Group
in accordance with P.A. 345

Chairman *William J. Quinn*
Date 12/17/98

Signed by Delmer E. Porter
Surveyor's Michigan License No. #15410

Date Dec 9, 1998