

2524

1998 PRESQUE ISLE COUNTY, STATE OF MICHIGAN REMONUMENTATION

LAND CORNER RECORDATION CERTIFICATE
Filing Requirement of Act 74, Mich. P.A. 1970

For corners in

<u>Presque Isle</u> (County)	Located In:	Corner Code #
1. Public Land Survey	T34NR 4E	H-13
	T___R___	_____
	T___R___	_____
	T___R___	_____
2. Property Controlling in Section	S___T___R___	_____
	S___T___R___	_____
3. Miscellaneous Property in Sec.	S___T___R___	_____
	S___T___R___	_____

PRESQUE ISLE COUNTY
RECORDED

98 DEC 17 PM 4:27

John M. Lamb
REGISTER OF DEEDS

Register of Deeds Stamp & File Number

4. Lot No. _____, Recorded Plat _____
5. Private Claims _____

I, Delmer E. Porter in a field survey on Jan. 9, 1998 do hereby state that under requirements of P.A. 74, Michigan P.A. of 1970, the corner points mentioned in lines 1 and 2 above were in conformance with regulations and rules therefore as required in the current manual of survey instructions of the United States Department of the Interior, Bureau of Land Management or by a decree of a Court of Law and /or that the corner points mentioned in lines 3, 4 and 5 above were in conformance with the rules of the Michigan Board of Land Surveyors or by a Decree of a Court of Law; established, re-established, monumented, recovered, found as expressed below:

NOTE: Not more than 2 corners, all in the same town and range, may be recorded on this certificate.

	A	B	C	D	E	F	G	H	I	J	K	L	M
1													
2	6		5		4		3		2		1		
3													
4	7		8		9		10		11		12		
5													
6	18		17		16		15		14		13		
7													
8	19		20		21		22		23		24		
9													
10	30		29		28		27		26		25		
11													
12	31		32		33		34		35		36		
13													

A. Description of original monument and accessories and/or subsequent restoration:

H-13 GLO Notes	Conc Mon & Brass Cap	1/2" Bar
June 20, 1856	N14°E 45.75' 6" Cedar	N14°E 45.65' 6" Cedar
Set 1/4 sec post	S22°E 57.28' 9" Cedar	S22°E 57.28' 9" Cedar
Cedar 18 N77E 22	S40°W 60.66' 9" Cedar	S40°W 50.66' 9" Cedar
Do 12 N49W 9		

B. Description of corner evidence found and/or method applied in restoring or reestablishing corner:

H-13 1/2" Iron Set Cap #21559
N14°E 45.66' 6" Cedar
S22°E 57.23' 10" Cedar
S40°W 60.48' 10" Cedar
S20°W 32.42' 8" Balsam


SURVEY &
REMONUMENTATION

JAN 14 1999

SECTION

C. Description of monument for corner and accessories established to perpetuate locating the position of the corner:

H-13 1/2" Rod & Cap #21559
N16°E 45.75' 13" Cedar
S12°E 57.24' 10" Cedar
S42°W 60.54' 12" Cedar
N51°W 32.07' 4" Spruce

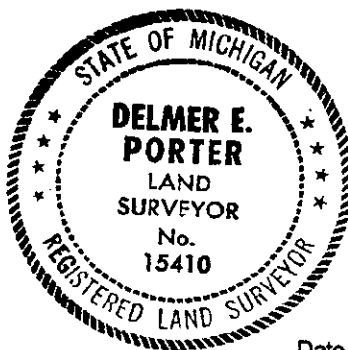

Ratified by Peer Group
in accordance with P.A. 345

Chairman *Norman J. Osinski*
Date 12/17/98

Signed by Delmer E. Porter
Surveyor's Michigan License No. #15410

Date Dec 9, 1998