

2364
SURVEY & REMONUMENTATION

JAN 14 1999

LIBER 329 PAGE 600

SECTION

1998 Presque Isle County State of Michigan Land Corner Remonumentation

LAND CORNER RECORDATION CERTIFICATE
 Filing Requirement of Act 74, Mich. P.A. 1970

For corners in

Presque Isle County
 (County)

Located in:
 Bismarck

Corner Code #

1. Public Land Survey

T 34N R 4E I-10

2. Property Controlling in Section

S T R

3. Miscellaneous Property in Sec.

S T R

4. Lot No. _____ Recorded Plat _____
 5. Private Claims _____

PRESQUE ISLE COUNTY
 RECORDED

98 NOV 25 AM 11:15

Janet M. Lamb
 REGISTER OF DEEDS

Register of Deeds Stamp & File Number

I, James A. Beck, in a field survey on August 12, 1998 do hereby state that under requirements of P.A. 74, Michigan P.A. of 1970, the corner points mentioned in lines 1 and 2 above were in conformance with regulations and rules therefore as required in the current manual of survey instructions of the United States Department of the Interior, Bureau of Land Management or by a decree of a Court of Law and for that the corner points mentioned in lines 3, 4 and 5 above were in conformance with the rules of the Michigan Board of Land Surveyors or by a Decree of a Court of Law, established, re-established, monumented, recovered, found as expressed below:

NOTE: Not more than 2 corners, all in the same town and range, may be recorded on this certificate.


	A	B	C	D	E	F	G	H	I	J	K	L	M
1													
2	6		5		4		3		2		1		
3													
4	7		8		9		10		11		12		
5													
6	16		17		16		15		14		13		
7													
8	19		20		21		22		23		24		
9													
10	30		29		28		27		26		25		
11													
12	31		32		33		34		35		36		
13													

A. Description of original monument and accessories and/or subsequent restoration:
 I-10 1856 G.L.O. by Alfred Millerd February 16, 1987 P.A. 74 (Land Corner Recordation Certificate) by Delmer E. Porter No. 15410
 "Set 1/4 Sec. post" Part A: (of certificate)
 W. Birch 8 N58E 13 "GLO NOTES"
 Aspen 7 S28W 35 Part B: "No evidence of corner found
 Set 1/2" Rod & LLS Cap by Single proportion"
 Part C: 1/2" Rod & LLS Cap
 SET ON EDGE OF FIELD ROWS NO WITNESSES AVAILABLE

B. Description of corner evidence found and/or method applied in restoring or reestablishing corner:
 I-10 Found 1/2" iron rod and 15410 cap

Ratified by Peer Group
 in accordance with P.A. 345
 Chairman *William J. Quinn*
 Date 7/2/98

C. Description of monument for corner and accessories established to perpetuate locating the position of the corner:
 I-10 1/2" iron rod and 15410 cap
 Set the following witnesses: S 59°E 188.83', 2" W. Pine; S 7°E 133.95', 4" Poplar
 S 45°W 167.76', 25" Maple; S 85°W 157.60', 4" Poplar
 All witnesses have P.S. 21559 tags
 Also; South 0.6' to N. face of a 2" square metal post sprayed with orange glo paint set as guard post.
 Corner falls in tall grass in low area
 SW of oil or gas well installation.

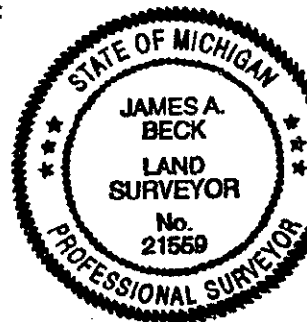

Signed by *James A. Beck*
 Surveyor's Michigan License No. 21559

Date October 5, 1998