

2003

1998 PRESQUE ISLE COUNTY, STATE OF MICHIGAN REMONUMENTATION

PRESQUE ISLE COUNTY
RECORDED
98 OCT 13 PM 3:56

LAND CORNER RECORDATION CERTIFICATE
Filing Requirement of Act 74, Mich. P.A. 1970

For corners in

<u>Presque Isle</u> (County)	Located In:	Corner Code #
Bismark Township		
1. Public Land Survey	T <u>34N</u> R <u>4E</u>	<u>K-3</u>
	T <u> </u> R <u> </u>	<u> </u>
	T <u> </u> R <u> </u>	<u> </u>
	T <u> </u> R <u> </u>	<u> </u>
2. Property Controlling in Section	S <u> </u> T <u> </u> R <u> </u>	<u> </u>
	S <u> </u> T <u> </u> R <u> </u>	<u> </u>
3. Miscellaneous Property in Sec.	S <u> </u> T <u> </u> R <u> </u>	<u> </u>
	S <u> </u> T <u> </u> R <u> </u>	<u> </u>

Janet M. Lamb
REGISTER OF DEEDS

Register of Deeds Stamp & File Number

4. Lot No. _____, Recorded Plat _____
5. Private Claims _____

I, Ronald Bischer, in a field survey on 6-1, 19 98 do hereby state that under requirements of P.A. 74, Michigan P.A. of 1970, the corner points mentioned in lines 1 and 2 above were in conformance with regulations and rules therefore as required in the current manual of survey instructions of the United States Department of the Interior, Bureau of Land Management or by a decree of a Court of Law and /or that the corner points mentioned in lines 3, 4 and 5 above were in conformance with the rules of the Michigan Board of Land Surveyors or by a Decree of a Court of Law; established, re-established, monumented, recovered, found as expressed below:

A	B	C	D	E	F	G	H	I	J	K	L	M
1												
2	6	5	4	3	2	1						
3										●		
4	7	8	9	10	11	12						
5												
6	18	17	16	15	14	13						
7												
8	19	20	21	22	23	24						
9												
10	30	29	28	27	26	25						
11												
12	31	32	33	34	35	36						
13												


NOTE: Not more than 2 corners, all in the same town and range, may be recorded on this certificate.

A. Description of original monument and accessories and/or subsequent restoration:

K-3
1856 Alfred Millerd
set wood post and 2 witnesses
1943+/- G.F.Delamater #2674
found 3 old points set 1/2"x48" bar in corner
2 new witnesses
Sept.1, 1978 Delmer Porter #15410
found 1/2" bar and two cedar stakes
set conc. mon with brass cap and 3 witnesses

B. Description of corner evidence found and/or method applied in restoring or reestablishing corner:

K-3
found conc mon and 3 witnesses

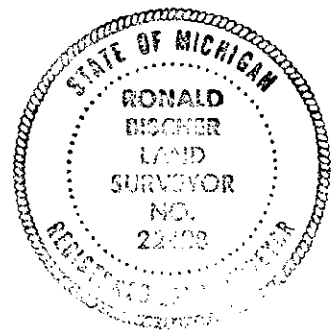

SURVEY &
REMONUMENTATION

JAN 14 1999

SECTION

C. Description of monument for corner and accessories established to perpetuate locating the position of the corner:

K-3
conc. mon with brass cap

N30°E 46.22' 9" Cedar O.W.
S49°E 36.48' 7" Maple O.W.
S27°E 16.20' 5" Ash
N25°W 58.08' 9" Maple O.W.

Ratified by Peer Group
in accordance with P.A. 345

Chairman *Norman Quame*
Date 7/2/98

Signed by *Ronald R. Bischer*
Surveyor's Michigan License No. 22428

Date Sept. 28, 1998