

2004

1998 PRESQUE ISLE COUNTY, STATE OF MICHIGAN REMONUMENTATION PRESQUE ISLE COUNTY RECORDED

LAND CORNER RECORDATION CERTIFICATE Filing Requirement of Act 74, Mich. P.A. 1970

98 OCT 13 PM 3: 56

For corners in

Presque Isle (County)	Located In:	Corner Code #
Bismark Township		
1. Public Land Survey	T 34N R 4E	K-4
	T R	
	T R	
	T R	
2. Property Controlling in Section	S T R	
	S T R	
3. Miscellaneous Property in Sec.	S T R	
	S T R	

Janet M. Lamb REGISTER OF DEEDS

Register of Deeds Stamp & File Number

4. Lot No. , Recorded Plat
5. Private Claims

I, Ronald Bischer, in a field survey on 6-1, 1998 do hereby state that under requirements of P.A. 74, Michigan P.A. of 1970, the corner points mentioned in lines 1 and 2 above were in conformance with regulations and rules therefore as required in the current manual of survey instructions of the United States Department of the Interior, Bureau of Land Management or by a decree of a Court of Law and/or that the corner points mentioned in lines 3, 4 and 5 above were in conformance with the rules of the Michigan Board of Land Surveyors or by a Decree of a Court of Law; established, re-established, monumented, recovered, found as expressed below:

NOTE: Not more than 2 corners, all in the same town and range, may be recorded on this certificate.

A	B	C	D	E	F	G	H	I	J	K	L	M
1												
2	6	5	4	3	2	1						
3												
4	7	8	9	10	11	12						
5												
6	18	17	16	15	14	13						
7												
8	19	20	21	22	23	24						
9												
10	30	29	28	27	26	25						
11												
12	31	32	33	34	35	36						
13												

A. Description of original monument and accessories and/or subsequent restoration:

K-4
1856 Alfred Millerd
Set wood post and 2 witnesses
1943 +/- G.F. DelaMater #2674
found both witness trees set 1/2"x48" bar


Sept. 15, 1982 Ronald Bischer #22428
found 1/2" rod and 2 stakes set 3 new witnesses

B. Description of corner evidence found and/or method applied in restoring or reestablishing corner:

K-4
1/2" rod and 1 square stake

C. Description of monument for corner and accessories established to perpetuate locating the position of the corner:

K-4
1/2" rod and 1 square stake
S82°E 30.45' 5" Balsam O.W.
S71°E 32.02' 5" Tamarack
S38°W 24.60' 6" Aspen O.W.
S47°W 21.43' 3" Maple

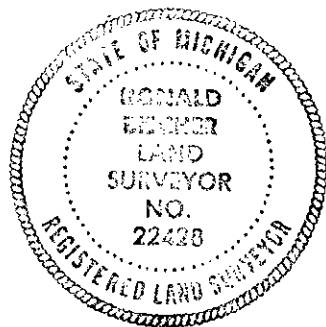

SURVEY & REMONUMENTATION

JAN 14 1999

SECTION

Ratified by Peer Group in accordance with P.A. 345

Chairman Norman J. Quinn
Date 7/2/98

Signed by Ronald R. Bischer
Surveyor's Michigan License No. 22428

Date Sept. 28, 1998