

2012

1998 PRESQUE ISLE COUNTY, STATE OF MICHIGAN REMONUMENTATION

LAND CORNER RECORDATION CERTIFICATE  
Filing Requirement of Act 74, Mich. P.A. 1970

PRESQUE ISLE COUNTY  
RECORDED  
98 OCT 13 PM 3:57

*Janet M. Lamb*  
REGISTER OF DEEDS

For corners in

<u>Presque Isle</u>	Located In:	Corner Code #
(County)		
<u>Bismark Township</u>		
1. Public Land Survey	T <u>34</u> R <u>4E</u>	<u>K-12</u>
	T <u>   </u> R <u>   </u>	<u>   </u>
	T <u>   </u> R <u>   </u>	<u>   </u>
	T <u>   </u> R <u>   </u>	<u>   </u>
2. Property Controlling	S <u>   </u> T <u>   </u> R <u>   </u>	<u>   </u>
in Section	S <u>   </u> T <u>   </u> R <u>   </u>	<u>   </u>
3. Miscellaneous	S <u>   </u> T <u>   </u> R <u>   </u>	<u>   </u>
Property in Sec.	S <u>   </u> T <u>   </u> R <u>   </u>	<u>   </u>

Register of Deeds Stamp & File Number

4. Lot No. \_\_\_\_\_, Recorded Plat \_\_\_\_\_  
5. Private Claims \_\_\_\_\_


I, Ronald Bischer, in a field survey on 6-9, 19 98 do hereby state that under requirements of P.A. 74, Michigan P.A. of 1970, the corner points mentioned in lines 1 and 2 above were in conformance with regulations and rules therefore as required in the current manual of survey instructions of the United States Department of the Interior, Bureau of Land Management or by a decree of a Court of Law and /or that the corner points mentioned in lines 3, 4 and 5 above were in conformance with the rules of the Michigan Board of Land Surveyors or by a Decree of a Court of Law; established, re-established, monumented, recovered, found as expressed below:

NOTE: Not more than 2 corners, all in the same town and range, may be recorded on this certificate.

	A	B	C	D	E	F	G	H	I	J	K	L	M
1													
2	6	5	4	3	2	1							
3													
4	7	8	9	10	11	12							
5													
6	18	17	16	15	14	13							
7													
8	19	20	21	22	23	24							
9													
10	30	29	28	27	26	25							
11													
12	31	32	33	34	35	36							
13													

A. Description of original monument and accessories and/or subsequent restoration:

K-12  
1856 Alfred Millerd  
Set wood post and 2 witnesses  
May 6, 1982 Ronald Bischer #22428  
set 1/2" rod and cap by Single proportion  
left 3 witnesses

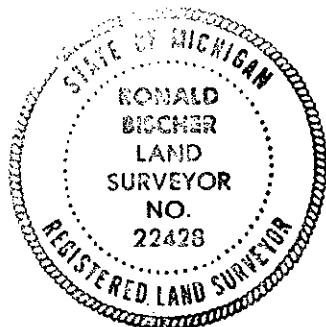

B. Description of corner evidence found and/or method applied in restoring or reestablishing corner:

K-12  
found 1/2" rod bent replaced with  
1/2" rod and cap #22428

SURVEY &  
REMONUMENTATION

JAN 14 1999

SECTION

C. Description of monument for corner and accessories established to perpetuate locating the position of the corner:

K-12  
1/2" rod and cap #22428  
  
S74°E 40.37' 36" Willow O.W. #15410  
N60°E 46.26' 3" Elm  
N36°W 37.87' 3" Maple  
S28°E 89.37' 9" Maple O.W. #15410

Ratified by Peer Group  
in accordance with P.A. 345  
Chairman *Norman J. Quinn*  
Date 7/2/98

Signed by *Ronald R. Bischer*  
Surveyor's Michigan License No. 22428

Date Sept. 28, 1998