

PRESQUE ISLE COUNTY
RECORDED

98 OCT 13 PM 3:57

1998 PRESQUE ISLE COUNTY, STATE OF MICHIGAN REMONUMENTATION

LAND CORNER RECORDATION CERTIFICATE
Filing Requirement of Act 74, Mich. P.A. 1970

Janice M. Lamb
REGISTER OF DEEDS

For corners in

Presque Isle (County) Bismark Township	Located in:	Corner Code #
1. Public Land Survey	T 34 N R 4 E	K-13
	T ___ R ___	_____
	T ___ R ___	_____
	T ___ R ___	_____
2. Property Controlling in Section	S ___ T ___ R ___	_____
	S ___ T ___ R ___	_____
3. Miscellaneous Property in Sec.	S ___ T ___ R ___	_____
	S ___ T ___ R ___	_____

Register of Deeds Stamp & File Number

4. Lot No. _____, Recorded Plat _____
5. Private Claims _____

I, Ronald Bischer, in a field survey on 6-9, 19 98 do hereby state that under requirements of P.A. 74, Michigan P.A. of 1970, the corner points mentioned in lines 1 and 2 above were in conformance with regulations and rules therefore as required in the current manual of survey instructions of the United States Department of the Interior, Bureau of Land Management or by a decree of a Court of Law and /or that the corner points mentioned in lines 3, 4 and 5 above were in conformance with the rules of the Michigan Board of Land Surveyors or by a Decree of a Court of Law; established, re-established, monumented, recovered, found as expressed below:


NOTE: Not more than 2 corners, all in the same town and range, may be recorded on this certificate.

	A	B	C	D	E	F	G	H	I	J	K	L	M
1													
2	6		5		4		3		2		1		
3													
4	7		8		9		10		11		12		
5													
6	18		17		16		15		14		13		
7													
8	19		20		21		22		23		24		
9													
10	30		29		28		27		26		25		
11													
12	31		32		33		34		35		36		
13													

A. Description of original monument and accessories and/or subsequent restoration:

K-13
1840 George Hodgson
set wood post and 2 witnesses

June 20, 1978
Delmer Porter #15410
found 1 1/2" pipe 3 witnesses

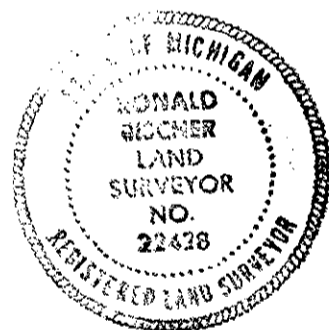

SURVEY &
REMONUMENTATION

JAN 14 1999

SECTION

B. Description of corner evidence found and/or method applied in restoring or reestablishing corner:

K-13
found 1 1/2" pipe in intersection

C. Description of monument for corner and accessories established to perpetuate locating the position of the corner:

K-13
1 1/2" pipe in intersection

S38°E 58.79' Fence Post
N56°E 49.65' P. Pole O.W. #15410
N41°W 45.21' Fence corner O.W. #15410
S38°W 93.15' 5" Scotch Pine
S33°E 55.53' old fence cor lying down O.W. #15410

Ratified by Peer Group
in accordance with P.A. 345

Chairman *Norman J. Dur*

Date 7/2/98

Signed by Ronald R. Bischer
Surveyor's Michigan License No. 22428

Date Sept. 28, 1998