

2014

1998 PRESQUE ISLE COUNTY, STATE OF MICHIGAN REMONUMENTATION

PRESQUE ISLE COUNTY
RECORDED

LAND CORNER RECORDATION CERTIFICATE
Filing Requirement of Act 74, Mich. P.A. 1970

98 OCT 13 PM 3:57

For corners in

Presque Isle	Located In:	Corner Code #
(County)		
Bismark Township		
1. Public Land Survey	T 34 N 4 E	L-1
	T R	
	T R	
	T R	
2. Property Controlling in Section	S T R	
	S T R	
3. Miscellaneous Property in Sec.	S T R	
	S T R	

Jane M. Lamb
REGISTER OF DEEDS

Register of Deeds Stamp & File Number

4. Lot No. _____, Recorded Plat _____
5. Private Claims _____


I, Ronald Bischer, in a field survey on 6-9, 19 98 do hereby state that under requirements of P.A. 74, Michigan P.A. of 1970, the corner points mentioned in lines 1 and 2 above were in conformance with regulations and rules therefore as required in the current manual of survey instructions of the United States Department of the Interior, Bureau of Land Management or by a decree of a Court of Law and /or that the corner points mentioned in lines 3, 4 and 5 above were in conformance with the rules of the Michigan Board of Land Surveyors or by a Decree of a Court of Law; established, re-established, monumented, recovered, found as expressed below:

NOTE: Not more than 2 corners, all in the same town and range, may be recorded on this certificate.

	A	B	C	D	E	F	G	H	I	J	K	L	M
1													
2	6	5	4	3	2	1							
3													
4	7	8	9	10	11	12							
5													
6	18	17	16	15	14	13							
7													
8	19	20	21	22	23	24							
9													
10	30	29	28	27	26	25							
11													
12	31	32	33	34	35	36							
13													

A. Description of original monument and accessories and/or subsequent restoration:

L-1
1856 Alfred Millerd
set wood post and 2 witnesses

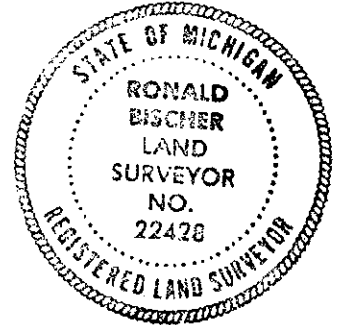

B. Description of corner evidence found and/or method applied in restoring or reestablishing corner:

L-1
Set 1/2" rod and cap #22428 in centerline of Heythelar road by single proportion left 4 witnesses

SURVEY &
REMONUMENTATION

JAN 14 1999

SECTION

C. Description of monument for corner and accessories established to perpetuate locating the position of the corner:

L-1
1/2" rod and cap #22428
S20°W 36.05' P. Pole
S49°E 76.90' 4" Scotch Pine
North 20.00' 1/2" rod
South 20.00' 1/2" rod
fence running south from corner

Ratified by Peer Group
in accordance with P.A. 345

Chairman *[Signature]*
Date 7/2/98

Signed by Ronald R. Bischer
Surveyor's Michigan License No. 22428

Date Sept. 28, 1998