

2015

PRESQUE ISLE COUNTY  
RECORDED

1998 PRESQUE ISLE COUNTY, STATE OF MICHIGAN REMONUMENTATION

LAND CORNER RECORDATION CERTIFICATE 98 OCT 13 PM 3:57  
Filing Requirement of Act 74, Mich. P.A. 1970

For corners in

Presque Isle  
(County)

Located In:

Corner Code #

Bismark Township  
1. Public Land Survey

T 34 N R 4E L-3

T \_\_\_\_\_ R \_\_\_\_\_

T \_\_\_\_\_ R \_\_\_\_\_

T \_\_\_\_\_ R \_\_\_\_\_

2. Property Controlling  
in Section

S \_\_\_\_\_ T \_\_\_\_\_ R \_\_\_\_\_

S \_\_\_\_\_ T \_\_\_\_\_ R \_\_\_\_\_

3. Miscellaneous  
Property in Sec.

S \_\_\_\_\_ T \_\_\_\_\_ R \_\_\_\_\_

S \_\_\_\_\_ T \_\_\_\_\_ R \_\_\_\_\_

*Janet M. Lamb*  
REGISTER OF DEEDS

Register of Deeds Stamp & File Number

4. Lot No. \_\_\_\_\_, Recorded Plat \_\_\_\_\_  
5. Private Claims \_\_\_\_\_

	A	B	C	D	E	F	G	H	I	J	K	L	M
1													
2		6		5		4		3		2		1	
3													
4		7		8		9		10		11		12	
5													
6		18		17		16		15		14		13	
7													
8		19		20		21		22		23		24	
9													
10		30		29		28		27		26		25	
11													
12		31		32		33		34		35		36	
13													


I, Ronald Bischer, in a field survey on 6-9, 1998 do hereby state that under requirements of P.A. 74, Michigan P.A. of 1970, the corner points mentioned in lines 1 and 2 above were in conformance with regulations and rules therefore as required in the current manual of survey instructions of the United States Department of the Interior, Bureau of Land Management or by a decree of a Court of Law and /or that the corner points mentioned in lines 3, 4 and 5 above were in conformance with the rules of the Michigan Board of Land Surveyors or by a Decree of a Court of Law; established, re-established, monumented, recovered, found as expressed below.

NOTE: Not more than 2 corners, all in the same town and range, may be recorded on this certificate.

A. Description of original monument and accessories and/or subsequent restoration:

L-3

1856 Alfred Millerd  
Set wood post and 2 witnesses

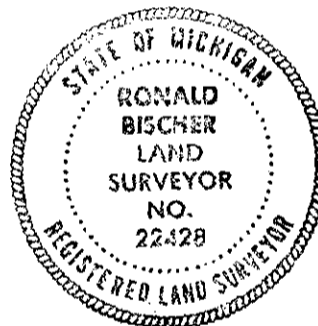

B. Description of corner evidence found and/or method applied in restoring or reestablishing corner:

L-3

Set 1/2" rod and cap #22428  
by single proportion

SURVEY &  
REMONUMENTATION

JAN 14 1999

SECTION

C. Description of monument for corner and accessories established to perpetuate locating the position of the corner:

L-3

1/2" rod and cap #22428

S31°W 52.09' 12" Beech  
S16°E 40.66' 14" Hemlock  
N17°W 39.14' 30" Maple  
N53°E 29.96' 8" Ash  
old fence running north from corner

Ratified by Peer Group  
in accordance with P.A. 345

Chairman Norman J. Quinn

Date 7/2/98

Signed by Ronald R. Bischer

Surveyor's Michigan License No. 22428

Date Sept. 28, 1998