

1998 PRESQUE ISLE COUNTY, STATE OF MICHIGAN REMONUMENTATION

PRESQUE ISLE COUNTY
RECORDED

98 OCT 13 PM 3:58

LAND CORNER RECORDATION CERTIFICATE
Filing Requirement of Act 74, Mich. P.A. 1970

Janet M. Lambert
REGISTER OF DEEDS

For corners in
Presque Isle
(County)

Located In:

Corner Code #

Bismark Township
1. Public Land Survey

T	<u>34N</u>	R	<u>4E</u>	L	<u>9</u>
T	_____	R	_____	_____	_____
T	_____	R	_____	_____	_____
T	_____	R	_____	_____	_____
S	_____	T	_____	_____	_____
S	_____	T	_____	_____	_____
S	_____	T	_____	_____	_____
S	_____	T	_____	_____	_____

2. Property Controlling
in Section

3. Miscellaneous
Property in Sec.

4. Lot No. _____, Recorded Plat _____
5. Private Claims _____

Register of Deeds Stamp & File Number

I, Ronald Bischer, in a field survey on 6-16, 1998 do hereby state that under requirements of P.A. 74, Michigan P.A. of 1970, the corner points mentioned in lines 1 and 2 above were in conformance with regulations and rules therefore as required in the current manual of survey instructions of the United States Department of the Interior, Bureau of Land Management or by a decree of a Court of Law and for that the corner points mentioned in lines 3, 4 and 5 above were in conformance with the rules of the Michigan Board of Land Surveyors or by a Decree of a Court of Law; established, re-established, monumented, recovered, found as expressed below:

NOTE: Not more than 2 corners, all in the same town and range, may be recorded on this certificate.


	A	B	C	D	E	F	G	H	I	J	K	L	M
1													
2	6		5		4		3		2		1		
3													
4	7		8		9		10		11		12		
5													
6	18		17		16		15		14		13		
7													
8	19		20		21		22		23		24		
9													
10	30		29		28		27		26		25		
11													
12	31		32		33		34		35		36		
13													

A. Description of original monument and accessories and/or subsequent restoration:

L-9
1856 Alfred Millerd
Set wood 1/4 post and 2 witnesses

B. Description of corner evidence found and/or method applied in restoring or reestablishing corner:

L-9
Set 1/2" rod and cap #22428 off end of fence to south in centerline of Noffze road

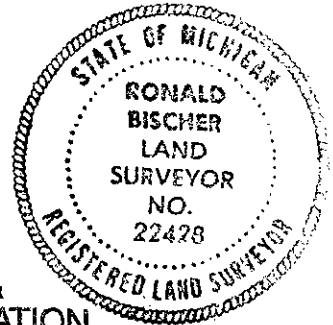

SURVEY &
REMONUMENTATION

JAN 14 1999

SECTION

C. Description of monument for corner and accessories established to perpetuate locating the position of the corner:

L-9
1/2" rod and cap #22428
N09°E 33.14' Fence post
S22°W 39.95' 7" Maple
S09°W 35.47' Fence Corner
S53°E 41.67' 3" Balsam

Ratified by Peer Group
in accordance with P.A. 345

Chairman Norman J. Quisner
Date 7/2/98

Signed by Ronald R. Bischer
Surveyor's Michigan License No. 22428

Date Sept. 28, 1998