

LAND CORNER RECORDATION CERTIFICATE
Filing Requirement of Act 74, Mich. P.A. 1970

For corners in

<u>PRESQUE ISLE</u> (County)	Located In:	Corner Code #
1. Public Land Survey	T <u>34NR</u> <u>4E</u>	<u>C-3, B-3</u>
	T <u> </u> <u> </u>	<u> </u>
	T <u> </u> <u> </u>	<u> </u>
	T <u> </u> <u> </u>	<u> </u>
2. Property Controlling in Section	S <u> </u> T <u> </u> R <u> </u>	<u> </u>
	S <u> </u> T <u> </u> R <u> </u>	<u> </u>
3. Miscellaneous Property in Sec.	S <u> </u> T <u> </u> R <u> </u>	<u> </u>
	S <u> </u> T <u> </u> R <u> </u>	<u> </u>

Register of Deeds Stamp & File Number

4. Lot No. _____, Recorded Plat _____
 5. Private Claims _____

I, CARL T. KIISKILA, in a field survey on May 20, 19 97 do hereby state that under requirements of P.A. 74, Michigan P.A. of 1970, the corner points mentioned in lines 1 and 2 above were in conformance with regulations and rules therefore as required in the current manual of survey instructions of the United States Department of the Interior, Bureau of Land Management or by a decree of a Court of Law and/or that the corner points mentioned in lines 3, 4 and 5 above were in conformance with the rules of the Michigan Board of Land Surveyors or by a Decree of a Court of Law, established, re-established, monumented, recovered, found as expressed below:

NOTE: Not more than 2 corners, all in the same town and range, may be recorded on this certificate.

A	B	C	D	E	F	G	H	I	J	K	L	M
1												
2	6		5		4		3		2		1	
3	•	•										
4	7		8		9		10		11		12	
5												
6	18		17		16		15		14		13	
7												
8	19		20		21		22		23		24	
9												
10	30		29		28		27		26		25	
11												
12	31		32		33		34		35		36	
13												

A. Description of original monument and accessories and/or subsequent restoration:
 C-3 B-3

(NO EVIDENCE OF G.L.O. CORNER, B.T'S, LINE TREES & TOPOGRAPHY, AS CALLED OUT IN THE G.L.O. LINE NOTES; UNLESS NOTED IN ITEM "B" BELOW.)

B. Description of corner evidence found and/or method applied in restoring or reestablishing corner:
 C-3 B-3


Fd. and accepted a 1/2" Rod for the NE Corner of Sec. 7 as set by Larry Beauregard, P.S.#18654. Cor fits L.B's. L.C.R.C. Page 395 and Certificate of Survey Li. 244, Pg. 151. Center of E-W trail road is 3' north.

Found and accepted a 1/2" Rod for the N1/4 corner of Sec. 7 as set by Larry Beauregard, P.S.#18654. Corner fits his L.C.R.C. Page 395 and Certificate of Survey Li. 244, Pg. 151. Center of E-W trail road is 3' South.

C. Description of monument for corner and accessories established to perpetuate locating the position of the corner:
 C-3 B-3

Found 1/2" Rod w/cap, placed 1" Iron Pipe over 1/2" Rod.
 †14" R.Pine N05°E 19.91'
 †14" Tw.R.Pine N57°E 38.83'
 4" J.Pine S18°E 37.54'
 8" Tw.R.Pine N60°W 53.35'
 2 1/2" Iron Pipe N76°W 7.56'
 Set carsonite Post South 15'

Found 1/2" Iron Rod, placed 1" Pipe over fd. Rod.
 8" Oak S06°W 30.35'
 14" R.Pine S79°W 60.12'
 18" R.Pine N10°W 45.26'
 8" Oak N52°E 30.61'

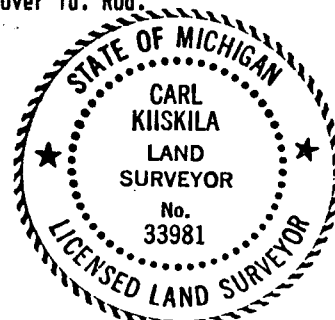

† = Old wit. by L.Beauregard, P.S.
 Signed by Carl T. Kiiskila
 Surveyor's Michigan License No. 33981

Date 5-29-97