LAND CORNER RECORDATION CERTIFICATE
Filing Requirement of Act 74, Mich. P.A. 1970

For corners in

PRESQUE ISLE
(County)

	Located In:		Corner Code #
1. Public Land Survey		T 34N R 4E	A-5
		T___ R___	
		T___ R___	
		T___ R___	
2. Property Controlling	S 7	T___ R___	15
in Section	S___	T___ R___	
3. Miscellaneous	S___	T___ R___	
Property in Sec.	S___	T___ R___	

Register of Deeds Stamp & File Number

4. Lot No. _____ , Recorded Plat _____
5. Private Claims _____

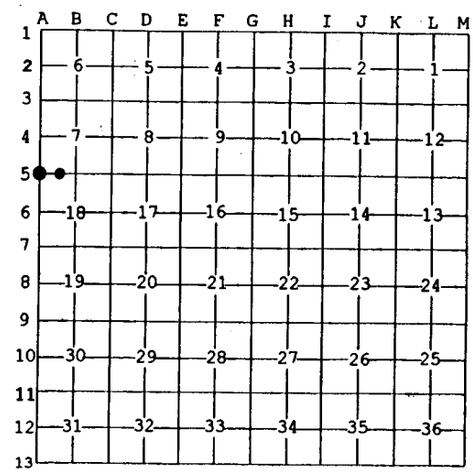

I, Carl T. Kiiskila, in a field survey on May 19, 19 97 do hereby state that under requirements of P.A. 74, Michigan P.A. of 1970, the corner points mentioned in lines 1 and 2 above were in conformance with regulations and rules therefore as required in the current manual of survey instructions of the United States Department of the Interior, Bureau of Land Management or by a decree of a Court of Law and /or that the corner points mentioned in lines 3, 4 and 5 above were in conformance with the rules of the Michigan Board of Land Surveyors or by a Decree of a Court of Law; established, re-established, monumented, recovered, found as expressed below:

NOTE: Not more than 2 corners, all in the same town and range, may be recorded on this certificate.

A. Description of original monument and accessories and/or subsequent restoration:

A-5 15

(NO EVIDENCE OF G.L.O. CORNER, B.T'S, LINE TREES & TOPOGRAPHY, AS CALLED OUT IN THE G.L.O. LINE NOTES; UNLESS NOTED IN ITEM "B" BELOW.)

B. Description of corner evidence found and/or method applied in restoring or reestablishing corner:

A-5

Found and accepted a Presque Isle Co. Conc. Monument with Brass cap for the SW corner of S-7 as witnessed by Larry Beauregard, P.S.#18654. Corner fits his L.C.R.C. Pg. 395 and Certificate of Survey Li. 244, Pg. 151. Center of E-W trail is 2 feet North and monument is on westerly edge of trail to North.

15

Established the SE corner of the Fractional SW1/4 of the fractional SW1/4 of Sec. 7 per standard BLM instructions.

C. Description of monument for corner and accessories established to perpetuate locating the position of the corner:

A-5

Found Presque Isle Co. Mon.

‡14" R.Pine	N25°W	72.13'
‡22" W.Pine	N47°E	31.93'
22" R.Pine	S77°W	37.82'
‡18" Oak	S23°E	18.21'

‡ = Old wit. by L.Beauregard.

15

Set 5/8"x 34" Rerod w/PS cap.

5" R.Pine	S52°E	34.94'
14" R.Pine	N57°E	18.49'
4" Oak	N28°W	37.55'
5" R.Pine	S76°W	42.66'

Set carsonite post South 10'

STATE OF MICHIGAN
CARL KIISKILA
LAND SURVEYOR
No. 33981
LICENSED LAND SURVEYOR

Signed by Carl T Kiiskila Date 5-29-97

Surveyor's Michigan License No. 33981

FORM APPROVED BY MICHIGAN STATE BOARD OF PROFESSIONAL SURVEYORS, JAN. 28, 1971
REVISED MAY 14,1975
REVISED JAN., 1983
REVISED OCT., 1995