

LAND CORNER RECORDATION CERTIFICATE
Filing Requirement of Act 74, Mich. P.A. 1970

For corners in

PRESQUE ISLE

(County)

Located In:

Corner Code #

1. Public Land Survey	T	<u>34</u> R	<u>4E</u>	<u>C-5</u>
	T	_____	_____	_____
	T	_____	_____	_____
	T	_____	_____	_____
2. Property Controlling in Section	S	<u>7</u>	T	R
	S	_____	T	R
3. Miscellaneous Property in Sec.	S	_____	T	R
	S	_____	T	R

Register of Deeds Stamp & File Number

4. Lot No. _____, Recorded Plat _____
 5. Private Claims _____

I, Carl T. Kiiskila, in a field survey on May 20, 1997 do hereby state that under requirements of P.A. 74, Michigan P.A. of 1970, the corner points mentioned in lines 1 and 2 above were in conformance with regulations and rules therefore as required in the current manual of survey instructions of the United States Department of the Interior, Bureau of Land Management or by a decree of a Court of Law and /or that the corner points mentioned in lines 3, 4 and 5 above were in conformance with the rules of the Michigan Board of Land Surveyors or by a Decree of a Court of Law, established, re-established, monumented, recovered, found as expressed below:

NOTE: Not more than 2 corners, all in the same town and range, may be recorded on this certificate.

A	B	C	D	E	F	G	H	I	J	K	L	M
1												
2	6		5		4		3		2		1	
3												
4	7		8		9		10		11		12	
5		●										
6	18		17		16		15		14		13	
7												
8	19		20		21		22		23		24	
9												
10	30		29		28		27		26		25	
11												
12	31		32		33		34		35		36	
13												

A. Description of original monument and accessories and/or subsequent restoration:
 C-5 13


(NO EVIDENCE OF G.L.O. CORNER, B.T.'S, LINE TREES & TOPOGRAPHY, AS CALLED OUT IN THE G.L.O. LINE NOTES; UNLESS NOTED IN ITEM "B" BELOW.)

B. Description of corner evidence found and/or method applied in restoring or reestablishing corner:
 C-5 13

Found and accepted a 1 1/2" Pipe for the SE corner of Sec. 7 as witnessed by Larry Beauregard, P.S.#18654. Corner fits L.C.R.C. Pg. 395 and Certificate of Survey Li. 244 Pg. 151. Center of N-S trail road is 310'+/- West. Established the SW corner of the NE1/4 of the SE1/4 of Sec. 7, per standard BLM instructions.

C. Description of monument for corner and accessories established to perpetuate locating the position of the corner:
 C-5 13

Found 1 1/2" Iron Pipe, Set carsonite post.	Set 5/8"x 32" Rerod w/PS cap and set carsonite post.
22" R.Pine N13°E 25.90'	9" Oak S12°W 8.70'
8" Oak S07°E 32.41'	12" Oak N89°W 35.27'
7" J.Pine S63°W 48.71'	3" R.Pine N10°W 24.24'
10" J.Pine N28°W 25.16'	5" R.Pine N53°E 20.28'

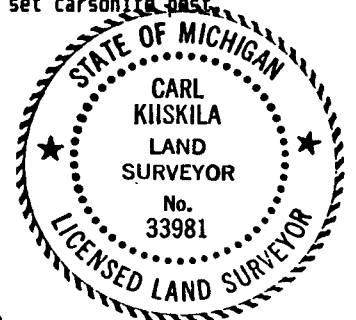

Signed by Carl T. Kiiskila
 Surveyor's Michigan License No. 33981

Date 5-29-97