LAND CORNER RECORDATION CERTIFICATE Filing Requirement of Act 74, Mich. P.A. 1970

	, ,,,,,,,,,,,,,,,,,,,,,,,,,,,,,,,,,,,,	
For corners in		
Presque Isle	Located In:	Corner Code ##
Public Land Survey	T 34N R 06E	L-8
	T R T R	
2. Property Controlling	S 24 T 34N R 06E S 24 T 34N R 06E	6 5


s ____ r .___ R .___


in Section

3. Miscellaneous Property in Sec. Register of Deeds Stamp & File Number

- _ , Recorded Plat __ 4. Lot No. . 5. Private Claims _
- I, Carl R. Johnson in a field survey on July 24, _{. 19} <u>90</u> do hereby certify that under requirements of P.A. 74, Michigan P.A. of 1970, the corner points mentioned in lines 1 and 2 above were in conformance with regulations and rules therefore as required in the current manual of survey instructions of the United States Department of the Interior, Bureau of Land Management or by a decree of a Court of Law and/or that the corner points mentioned in lines 3, 4 and 5 above were in conformance with the rules of the Michigan Board of Land Surveyors or by a Decree of a Court of Law, established, re-established, monumented, re-monumented, recovered, found as expressed below:

NOTE: Not more than 4 corners, all in the same town and range, may be recorded on this certificate.

 

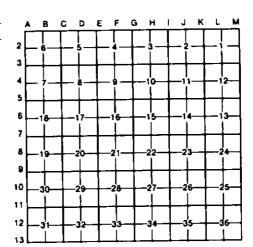

- B. Description of corner evidence found and/or method applied in restoring or reestablishing corner:
 - Set at Computed intersection of 1/4 lines as per survey and subdivision notes from a survey by Porter's Survey Co.
 - Set by standard survey procedure for subdivision of a section. 6
 - Set by standard survey procedure for subdivision of a section. 5
- C. Description of monument for corner and accessories established to perpetuate locating the position of the corner:

0. posen,p	
L-8 Center of Section 24	5 N1/8 Corner on N-S1 Line section 24
Set 5/8" Iron Bar w/cap	Set 5/8" Bar w/cap
w. Birch 6" S69°W 11.1 ft.	W. Birch 7" N86 ⁰ E 34.8ft.
Balsam 6" Sll°E 8.5 ft.	Twin W. Ash 8" S670E 33.3ft.
Aspen 8" S86°E 20.4 ft.	W. Birch 4" S08°E 43.6ft.
Maple 6" N30°E 24.0 ft.	l" Iron Rod S19 ^O E 40.1ft.
6 Center of NE' Section 24	
Set 5/8" Iron Bar w/cap	AND OF HEADING
W. Birch 4" N35°E 13.0 ft.	ALL CALLED
W. Birch 4" NO8°W 18.7 ft.	S CARL R.
Balsam 6" S65 W 14.2 ft.	JOHNBON H
Λ . (11)	Date 4/7/40 A LAND
Signed by	
300/3	FORM APPROVED BY MICHIGAN FOR BOARD ON SURVEY SAM.
Surveyor's Michigan Livense No.	MAY

CARL R. JOHNBON LAND URVEYOR CO LAND SURMAN 14, 1975

LAND SURMAN 14, 1983