

1993

LAND CORNER RECORDATION CERTIFICATE

DEC 20 PM 4:48

Filing Requirement of Act 74, Mich. P.A. 1970

COMMISSION

For corners in

Janet M. Lamb
REGISTER OF DEEDS

	PRESQUE ISLE (County)	Located In:	Corner Code #
1. Public Land Survey		T <u>34N</u> R <u>2E</u>	<u>A-5</u>
		T _____ R _____	_____
		T _____ R _____	_____
		T _____ R _____	_____
2. Property Controlling in Section	S _____ T _____ R _____	_____	_____
	S _____ T _____ R _____	_____	_____
3. Miscellaneous Property in Sec.	S _____ T _____ R _____	_____	_____
	S _____ T _____ R _____	_____	_____

LIBER **307** PAGE **876**

Register of Deeds Stamp & File Number

4. Lot No. _____, Recorded Plat _____
5. Private Claims _____

	A	B	C	D	E	F	G	H	I	J	K	L	M
2	6	5	4	3	2	1							
3													
4	7	8	9	10	11	12							
5													
6	18	17	16	15	14	13							
7													
8	19	20	21	22	23	24							
9													
10	30	29	28	27	26	25							
11													
12	31	32	33	34	35	36							
13													

I, Ronald R. Bischer, in a field survey on August 30, 19 93, do hereby certify that under requirements of P.A. 74, Michigan P.A. of 1970, the corner points mentioned in lines 1 and 2 above were in conformance with regulations and rules therefore as required in the current manual of survey instructions of the United States Department of the Interior, Bureau of Land Management or by a decree of a Court of Law and/or that the corner points mentioned in lines 3, 4 and 5 above were in conformance with the rules of the Michigan Board of Land Surveyors or by a Decree of a Court of Law; established, re-established, monumented, re-monumented, recovered, found as expressed below:


NOTE: Not more than 4 corners, all in the same town and range, may be recorded on this certificate.

A. Description of original monument and accessories and/or subsequent restoration:

A-5
June 2, 1840
John Hodgson set Wood Post
12" Beech S56°W 21 links
8" Beech N55°W 10 links
1979 - Ronald R. Bischer
Found 1" Axle shaft
(shaft assumed to be set by Bowen)
N70°W 37.31' Fence corner
S45°E 45.98' Power pole
S82°E 33.05' Gate post
Recorded on Page 392, Land Recordation,
June 8, 1979.

B. Description of corner evidence found and/or method applied in restoring or reestablishing corner:

A-5
Found Axle shaft buried 1.2' deep in gravel road.
S43°E 45.95' Power pole
Raised Axle shaft with 1/2" Rod and Cap #22428.

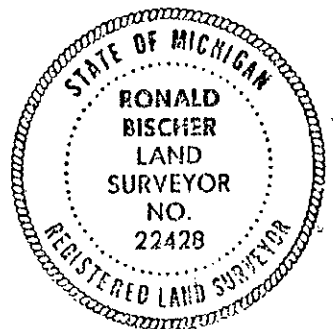

C. Description of monument for corner and accessories established to perpetuate locating the position of the corner:

A-5
1/2" Rod & Cap #22428
S43°E 45.95' Power pole
N43°W 42.47' Fence post
S68°W 71.12' 10" Spruce
S27°W 106.90' 4" Cedar

Ratified by Peer Group
in accordance with P.A. 345
Chairman *Delmer E. Porter*
Date December 7, 1993

*Witness tags and nails used.

Signed by Ronald R. Bischer Date 12-13-93
Surveyor's Michigan License No. 22428

CORNER HISTORY RESEARCH SHEET

LIBER 307 PAGE 877

A-5 Corner, Section 7, 8, Township 34N Range 2E

<u>Activity</u>	<u>Monument & Accessories</u>	<u>Comments</u>
1840 Original Survey John Hodgson	Set Wood Post 12" Beech S56°W 21 links 8" Beech N55°W 10 links	
1979 Ronald R. Bischer #22428	Found 1" Axle shaft Set 3 witnesses Recorded on Page 392, Land Recordation, June 8, 1979.	Axle shaft assumed to be set by David Bowen.
1993 Remonumentation Ronald R. Bischer #22428	Found axle shaft buried 1.2' deep raised with $\frac{1}{2}$ " Rod & cap #22428 S43°E 45.95' Power pole found nail w/tag #15410 N43°W 42.47' Fence post set nail w/tag #22428 S68°W 71.12' 10" Spruce set nail w/tag #22428 S27°W 106.90' 4" Cedar set nail w/tag #22428	

#3