

REMONU

1993

PRESQUE ISLE COUNTY
RECORDED

93 DEC 22 AM 10:00

COMMISSION LAND CORNER RECORDATION CERTIFICATE
Filing Requirement of Act 74, Mich. P.A. 1970

Janet M. Lamb
REGISTER OF DEEDS

For corners in

PRESQUE ISLE
(County)

Located In:

Corner Code #

- 1. Public Land Survey T 34N R 2E A-7
 T R
 T R
 T R
- 2. Property Controlling S T R
 in Section S T R
- 3. Miscellaneous S T R
 Property in Sec. S T R

Register of Deeds Stamp & File Number

- 4. Lot No. _____, Recorded Plat _____
- 5. Private Claims _____

	A	B	C	D	E	F	G	H	I	J	K	L	M
2	6	5	4	3	2	1							
3													
4	7	8	9	10	11	12							
5													
6	18	17	16	15	14	13							
7													
8	19	20	21	22	23	24							
9													
10	30	29	28	27	26	25							
11													
12	31	32	33	34	35	36							
13													

I, Delmer E. Porter in a field survey on Sept. 25, 1993

do hereby certify that under requirements of P.A. 74, Michigan P.A. of 1970, the corner points mentioned in lines 1 and 2 above were in conformance with regulations and rules therefore as required in the current manual of survey instructions of the United States Department of the Interior, Bureau of Land Management or by a decree of a Court of Law and/or that the corner points mentioned in lines 3, 4 and 5 above were in conformance with the rules of the Michigan Board of Land Surveyors or by a Decree of a Court of Law; established, re-established, monumented, re-monumented, recovered, found as expressed below:

NOTE: Not more than 4 corners, all in the same town and range, may be recorded on this certificate.

A. Description of original monument and accessories and/or subsequent restoration:

A-7 GLO NOTES
YELLOW PINE 12" N 30°E 10 lks.
CEDAR 7" S10°E 21' lks.

A-7 Sept. 29, 1980
Fnd. Plow Point in road centerline replaced with 1/2" rod & cap #15410 - DELMER E. PORTER Page 451, LAND CORNER RECORDS

WITNESSES

N 21° E 118.92' 7" BIRCH
N 84° E 13.24' 3/4" IRON BAR
S 17° E 136.68' TWIN MAPLES
S 50° W 117.03' POWER POLE
NOTE: IN 1979 RECORDS WERE FOUND THAT THE 3/4" IRON BAR 13.24' EAST WAS A BRIDGE CONTROL POINT PREVIOUSLY ASSUMED TO BE THE SECTION CORNER

B. Description of corner evidence found and/or method applied in restoring or reestablishing corner:


LOCATION

A-7
Sept. 25, 1993
Fnd. 1/2" rod & cap #15410
N 84° E 13.24' 3/4" BAR
S 50° W 112.02' POWER POLE
LEFT SAME WITNESSES

Ratified by Peer Group
in accordance with P.A. 345
Chairman Delmer E. Porter
Date December 14, 1993

C. Description of monument for corner and accessories established to perpetuate locating the position of the corner:

A-7
1/2" ROD & CAP #15410
N 43°E 55.06' 6" BASSWOOD
S 34° W 125.18' 4" ELM
S 23° E 103.35' 8" TWIN BIRCH
N 43° W 103.00' 8" RED PINE
* NAILS & TAGS #15410 USED IN WITNESS TREES.
PORTER'S SURVEY, P.C.

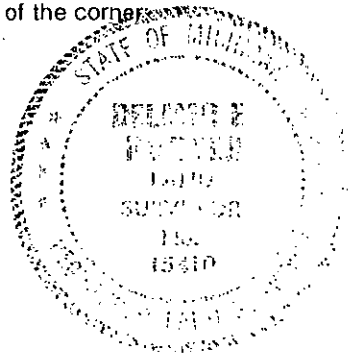

Signed by Delmer E. Porter

Date Dec 20, 1993

Surveyor's Michigan License No. 15410

CORNER HISTORY RESEARCH SHEET

A-7

T34N,R2E ALLIS TOWNSHIP-NORTH PART,
PRESQUE ISLE COUNTY, MICHIGAN.

ACTIVITY MONUMENT & ACCESSORIES - COMMENTS

<p>GLO Survey July 19, 1855</p>	<p>Yellow Pine 12" N30°E 10 Links Cedar 7" S10°E 21 Links</p>	}	<p>1979 found records that this was a Bridge Control Point 13.24' East of True Corner</p>
<p>Sept. 8, 1970 Porter's Survey Not Recorded</p>	<p>Fd. 2"x3/4"x3' Long bar buried 6" in Rd. Centerline N50°E 59.00' 20" Maple S80°E 56.10' 14" Elm S05°E 25.42' Fe.Post</p>		
<p>Act 74 filing by: Delmer E. Porter, #15410, Sept. 29, 1980, Page 451, Corner Recordation</p>	<p>Fd. Plow Point in Rd. Center- Line. Replaced with 1/2" Rod & Cap #15410 (D. Porter) N21°E 118.92' 7" Birch N84°E 13.24' 3/4" Iron Bar-Iron noted above S17°E 136.68' twin Maples S50°W 117.03' Power Pole Corner fits in line with fence to South and Rd. Centerline to North.</p>		
<p>Act 132 filing by: Porter's Survey Apr. 25, 1980, Survey #182-79 File #34R2109 Not Recorded</p>	<p>Same as Recorded above</p>		
<p>Act 132 filing by: Porter's Survey Survey #67-92 File #34R2263</p>	<p>Fd. 1/2" Rod & Cap (D. Porter #15410) N21°43' E 118.92 (Fd.) N68°W 67.82' Anchor Pole (New) N84°12' E 13.24' 3/4" Bar (Fd.) S17°E 136.68' Tw. Maple's (Fd.) S50°56'W 112.03' P.Pole (Fd.) Fd. 1/2" Rod & Cap, R. Bischer #22428 33.06' South on Sec. Line</p>	<p>Fd. 1/2" Rod & Cap, R. Bischer, #22428 33.06' South on Sec. Line</p>	
<p>Remonumentation Sept. 25, 1993</p>	<p>Fd. 1/2" Rod & cap 315410 (Fd.) N84°E 13.24' 3/4" Bar (Fd.) S50°W 112.03' P.Pole (Fd.) Left Same N43°E 55.06' 6" Basswood (New) S34°W 125.18' 4" Elm (New) S23°E 103.35' 8" Twin Birch (New) N43°W 103.00' 8" R. Pine (New)</p>		

~~ADJUST.~~ TO PAGE 196

h
/

SURVEY &
MONUMENTATION

JAN 22 2001

SECTION