

1993

PRESQUE ISLE COUNTY
RECORDED

93 DEC 22 AM 10:00

COMMISSION

LAND CORNER RECORDATION CERTIFICATE
Filing Requirement of Act 74, Mich. P.A. 1970

For corners in

	Located In:	Corner Code #
<u>PRESQUE ISLE</u> <small>(County)</small>		
1. Public Land Survey	T <u>34N</u> R <u>2E</u>	<u>A-8</u>
	T _____ R _____	_____
	T _____ R _____	_____
	T _____ R _____	_____
2. Property Controlling in Section	S _____ T _____ R _____	_____
	S _____ T _____ R _____	_____
3. Miscellaneous Property in Sec.	S _____ T _____ R _____	_____
	S _____ T _____ R _____	_____

Janet M. Lamb
REGISTER OF DEEDS

Register of Deeds Stamp & File Number

4. Lot No. _____, Recorded Plat _____
5. Private Claims _____

I, DELMER E. PORTER field survey on DEC. 9, 19 93, do hereby certify that under requirements of P.A. 74, Michigan P.A. of 1970, the corner points mentioned in lines 1 and 2 above were in conformance with regulations and rules therefore as required in the current manual of survey instructions of the United States Department of the Interior, Bureau of Land Management or by a decree of a Court of Law and/or that the corner points mentioned in lines 3, 4 and 5 above were in conformance with the rules of the Michigan Board of Land Surveyors or by a Decree of a Court of Law; established, re-established, monumented, re-monumented, recovered, found as expressed below:

	A	B	C	D	E	F	G	H	I	J	K	L	M
2	6	5	4	3	2	1							
3													
4	7	8	9	10	11	12							
5													
6	18	17	16	15	14	13							
7													
8	19	20	21	22	23	24							
9													
10	30	29	28	27	26	25							
11													
12	31	32	33	34	35	36							
13													

NOTE: Not more than 4 corners, all in the same town and range, may be recorded on this certificate.

A. Description of original monument and accessories and/or subsequent restoration:

A-8 GLO NOTES
JUNE 2, 1840
BEECH 12" S 24° W 15lks.
BEECH 6" N 80° W 43 lks.

WITNESSES
N 40° E 42.10' 10" MAPLE
S 80° E 49.20' 7" ASPEN
S 20° E 56.68' 10" ASPEN

A-8
P.S. 74 FILING BY RONALD R. BISCHER
L.S. #22428 OCT. 19, 1990 PAGE 815
LAND CORNER RECORDS

B. Description of corner evidence found and/or method applied in restoring or reestablishing corner:


A-8
FOUND 1/2" ROD & CAP #15410
N 42° E 41.90' 12" MAPLE

Ratified by Peer Group
in accordance with P.A. 345
Chairman *Delmer E. Porter*
Date Dec 18, 1993

C. Description of monument for corner and accessories established to perpetuate locating the position of the corner:

A-8
1/2" ROD & CAP #15410
N 42° E 41.90' 12" MAPLE
S 43° E 33.12' 4" TWIN ASPEN
S 17° E 31.21' 3" ASPEN
N 76° E 72.75' 10" MAPLE

* NAILS AND TAGS #15410 USED IN WITNESSES
PORTER'S SURVEY, P.C.

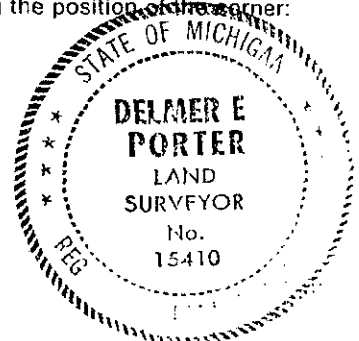

Signed by *Delmer E. Porter*

Date Dec 20, 1993

Surveyor's Michigan License No. 15410

CORNER HISTORY RESEARCH SHEET

A-8

T34N,R2E ALLIS TOWNSHIP-NORTH PART,
PRESQUE ISLE COUNTY, MICHIGAN.

ACTIVITY MONUMENT & ACCESSORIES - COMMENTS

GLO Survey
June 2, 1840

Beech 12" S24°W 15 Links
Beech 6" N80°W 43 Links

Act 74 filing by
Ronald R. Bischer #22428
Oct. 19, 1990, Page 815
Corner Recordation

Found 1/2" Rod
Left Same
N40°E 42.10' 10" Maple
S80°E 49.20' 7" Aspen
S20°E 56.68' 10" Aspen

Presque Isle
Remonumentation
Dec. 9, 1993

FD. 1/2" Rod & Cap #15410
& 12" Maple witness
N42°E 41.90' 12" Maple
S43°E 33.12' 4" Twin Aspen
S17°E 31.21' 3" Aspen
N76°E 72.75' 10" Maple
in E-W Fence

#3

SURVEY &
MONUMENTATION

JAN 22 2001

SECTION