

1993

PRESQUE ISLE COUNTY  
RECORDED

93 DEC 22 AM 10:00

LAND CORNER RECORDATION CERTIFICATE  
Filing Requirement of Act 74, Mich. P.A. 1970

*Jane M. Lamb*  
REGISTER OF DEEDS

For corners in

<u>PRESQUE ISLE</u> (County)	Located In:	Corner Code #
1. Public Land Survey	T <u>34N</u> <u>2E</u>	<u>A-9</u>
	T _____ R _____	_____
	T _____ R _____	_____
	T _____ R _____	_____
2. Property Controlling in Section	S _____ T _____ R _____	_____
	S _____ T _____ R _____	_____
3. Miscellaneous Property in Sec.	S _____ T _____ R _____	_____
	S _____ T _____ R _____	_____

Register of Deeds Stamp & File Number

4. Lot No. \_\_\_\_\_, Recorded Plat \_\_\_\_\_  
5. Private Claims \_\_\_\_\_

I, DEIMER E. PORTER a field survey on SEPT. 11, 1993, do hereby certify that under requirements of P.A. 74, Michigan P.A. of 1970, the corner points mentioned in lines 1 and 2 above were in conformance with regulations and rules therefore as required in the current manual of survey instructions of the United States Department of the Interior, Bureau of Land Management or by a decree of a Court of Law and/or that the corner points mentioned in lines 3, 4 and 5 above were in conformance with the rules of the Michigan Board of Land Surveyors or by a Decree of a Court of Law: established, re-established, monumented, re-monumented, recovered, found as expressed below:

	A	B	C	D	E	F	G	H	I	J	K	L	M
2	6		5		4		3		2		1		
3													
4	7		8		9		10		11		12		
5													
6	18		17		16		15		14		13		
7													
8	19		20		21		22		23		24		
9													
10	30		29		28		27		26		25		
11													
12	31		32		33		34		35		36		
13													

NOTE: Not more than 4 corners, all in the same town and range, may be recorded on this certificate.

A. Description of original monument and accessories and/or subsequent restoration:

A-9  
GLO NOTES  
BEECH 8" S 60° W 21 lks.  
BEECH 18" N 86° W 40 lks.

WITNESSES  
FOUND 1" ROD  
LEFT SAME  
NORTH 25.47' FENCE CORNER  
SOUTH 31.14' FENCE CORNER  
N 60° E 77.21' 6" ELM

A-9 DEC. 8, 1977  
P.A. 74 FILING BY RONALD R. BISCHER  
LLS #22428, PAGE 209, LAND CORNER  
RECORDS


B. Description of corner evidence found and/or method applied in restoring or reestablishing corner:

A-9  
SEPT. 11, 1993  
found 1" ROD  
N 77° E 76.94' 12" ELM  
LEFT SAME

Ratified by \_\_\_\_\_ Group  
in accordance with P.A. 345  
Chairman *Deimer E. Porter*  
Date December 14, 1993

C. Description of monument for corner and accessories established to perpetuate locating the position of the corner:

A-9  
1" ROD  
N 09° E 153.30' 6" ELM  
N 77° E 76.94' 12" ELM  
S 69° E 182.82' N.W. CORNER BARN  
S 86° W 133.06' 3" APPLE  
\* NAILS & TAGS #15410 USED ON WITNESSES  
PORTER'S SURVEY, P.C.

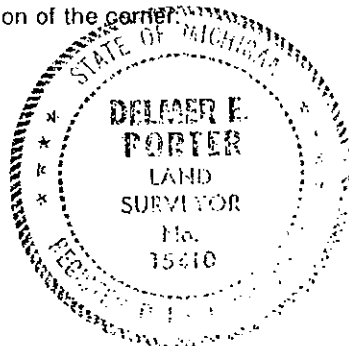

Signed by *Deimer E. Porter*

Date Dec 20, 1993

Surveyor's Michigan License No. 15410

# CORNER HISTORY RESEARCH SHEET

A-9

T34N,R2E ALLIS TOWNSHIP-NORTH PART,  
PRESQUE ISLE COUNTY, MICHIGAN.

## ACTIVITY                      MONUMENT & ACCESSORIES                      COMMENTS

GLO Survey  
June 2, 1840

Beech 8" S60°W 21 Links  
Beech 18" N86°W 40 Links

Act 74 filing by:  
Ronald R. Bischer,  
#22428, Dec. 8, 1977,  
Page 209, Corner  
Recordation

Fd. 1" Rod  
Left Same  
North 25.47' Fe. Cor.  
South 31.14' Fe. Cor.  
N60°E 77.21' 6" Elm

Remonumentation  
Sept. 11, 1993

Fd. 1" Rod  
N77°E 76.94' 6" Elm  
Left Same  
N09°E 153.30' 6" Elm  
N77°E 76.94' 12" Elm  
S69°E 182.82' NW Cor. Barn  
S86°W 133.06' 3" Apple

#3