

1993

PRESQUE ISLE COUNTY
RECORDED

93 DEC 22 AM 10:01

COMMISSION LAND CORNER RECORDATION CERTIFICATE
Filing Requirement of Act 74, Mich. P.A. 1970

Janet M. Lamb
REGISTER OF DEEDS

For corners in

<u>PRESQUE ISLE</u> <small>(County)</small>	Located In:	Corner Code #
1. Public Land Survey	T <u>34</u> N R <u>2</u> E	<u>A-12</u>
	T _____ R _____	_____
	T _____ R _____	_____
	T _____ R _____	_____
2. Property Controlling in Section	S _____ T _____ R _____	_____
	S _____ T _____ R _____	_____
3. Miscellaneous Property in Sec.	S _____ T _____ R _____	_____
	S _____ T _____ R _____	_____

Register of Deeds Stamp & File Number

- 4. Lot No. _____, Recorded Plat _____
- 5. Private Claims _____

I, DELMER E. PORTER, field survey on DEC. 8, 19 93,
do hereby certify that under requirements of P.A. 74, Michigan P.A. of 1970, the corner points mentioned
in lines 1 and 2 above were in conformance with regulations and rules therefore as required in the
current manual of survey instructions of the United States Department of the Interior, Bureau of Land
Management or by a decree of a Court of Law and/or that the corner points mentioned in lines 3, 4 and 5
above were in conformance with the rules of the Michigan Board of Land Surveyors or by a Decree of a
Court of Law; established, re-established, monumented, re-monumented, recovered, found as
expressed below:

A	B	C	D	E	F	G	H	I	J	K	L	P
2	6	5	4	3	2	1						
3												
4	7	8	9	10	11	12						
5												
6	18	17	16	15	14	13						
7												
8	19	20	21	22	23	24						
9												
10	30	29	28	27	26	25						
11												
12	31	32	33	34	35	36						
13												

NOTE: Not more than 4 corners, all in the same town and range, may be recorded on this certificate.

A. Description of original monument and accessories and/or subsequent restoration:

A-12 GLO NOTES	WITNESSES	
JUNE 2, 1840	N 53° W 16.06'	12" SPRUCE
4'8" PINE	N 43° W 13.91'	4" CEDAR
CEDAR 36" S 11° W 4 lks.	N 30° W 14.63'	6" CEDAR
HEMLOCK 24" N 53° W 16 lks.		

A-12 P.A. 74 FILING BY DELMER E. PORTER
L.S. #15410 NOV. 8, 1979 PAGE 410
LAND CORNER RECORDS

SET 4" CONCRETE MONUMENT IN 48" PINE STUMP


B. Description of corner evidence found and/or method applied in restoring or reestablishing corner:

A-12 DEC. 8, 1993
FOUND 4" CONCRETE MONUMENT WITH BRASS CAP
IN 48" STUMP
N 53° W 16.06' 12" SPRUCE
N 28° W 14.63' 8" CEDAR

Ratified by Peer Group
in accordance with P.A. 345
Chairman Delmer E. Porter
Date December 18, 1993

C. Description of monument for corner and accessories established to perpetuate locating the position of the corner:

A-12
4" CONCRETE MONUMENT WITH BRASS CAP
N 77° W 8.50' 7" CEDAR
N 28° W 14.63' 8" CEDAR
N 89° E 31.20' 11" CEDAR
S 01° W 22.75' 9" CEDAR
* NAILS AND TAGS #15410 USED ON WITNESS TREES
PORTER'S SURVEY, P.C.

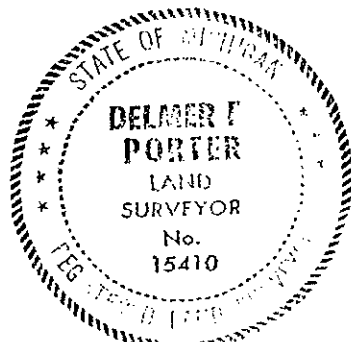

Signed by Delmer E. Porter

Date Dec 20, 1993

Surveyor's Michigan License No. 15410

CORNER HISTORY RESEARCH SHEET

A-12

T34N,R2E ALLIS TOWNSHIP-NORTH PART,
PRESQUE ISLE COUNTY, MICHIGAN.

ACTIVITY	MONUMENT & ACCESSORIES	COMMENTS
----------	------------------------	----------

GLO Survey
June 2, 1840

ORIGINAL CORNER,
Cedar 36" S11°W 4 Links
Hemlock 24" N53°W 16 Links

Act 74 Filing by
Delmer E. Porter #15410
Nov. 9, 1979, Page #410
Corner Recordation

Put Conc. Mon. in
48" Pine Stump
N53°W 16.06' 12" Spruce
N43°W 13.91' 4" Cedar
N30°W 14.63' 6" Cedar

*Assumed to
Be Original*

Presque Isle
Remonumentation
Dec. 8, 1993

FD. Conc. Mon. with brass cap
in 48" Stump. Fd. All
Witnesses but replaced to
spread them out
N77°W 8.50' 7" Cedar
N28°W 14.63' 8" Cedar
N89°E 31.20' 11" Cedar
S01°W 22.75' 9" Cedar

** /*